


T.38S.,R.4W.,WM.

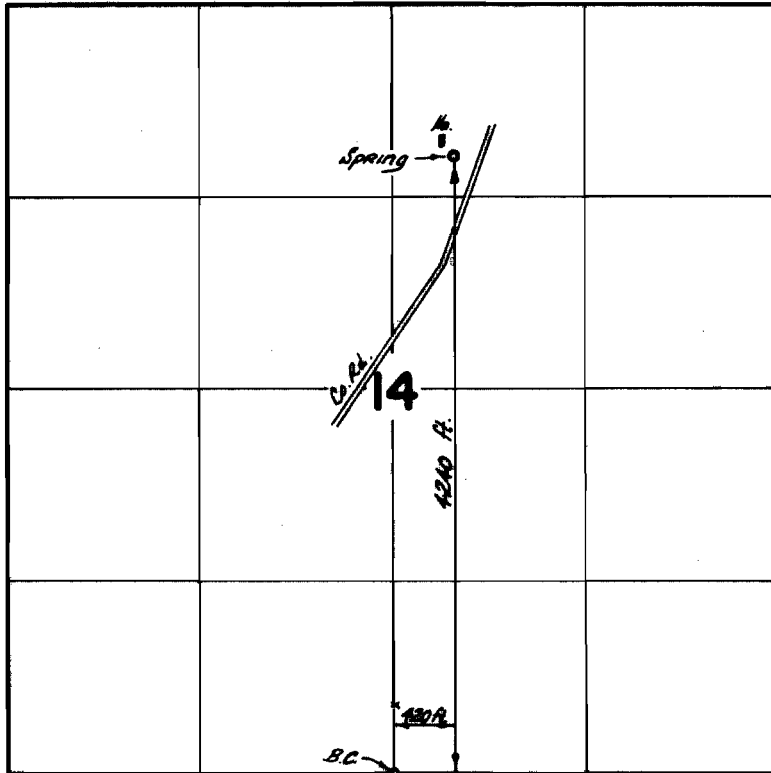

FINAL PROOF SURVEY
UNDER

Application No. 46418 Permit No. 34683
IN NAME OF

PIERCE W. MEADORS

Surveyed Oct. 11 1973, by D. Norsey