


T. 36 S.R. 4 W. W.M.

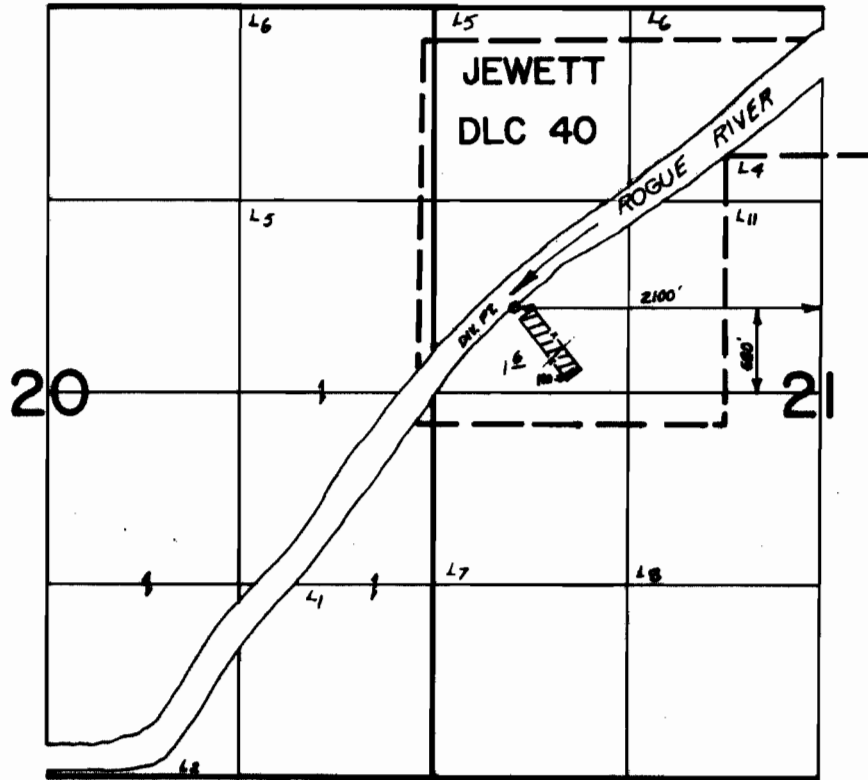

FINAL PROOF SURVEY
UNDER

Application No. 49130 Permit No. 36840
IN NAME OF

F. E. & MARION P. HUCHENDORF

Surveyed OCT 13 1973, by R.G. MUCKEN