


T. 35S.R. 2W. W.M.

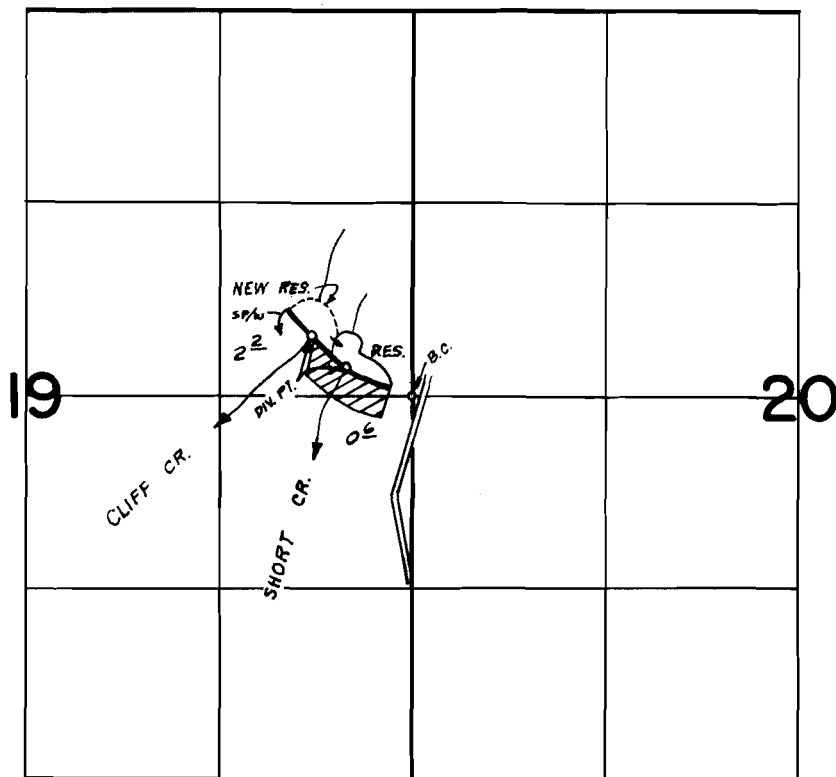

DIV. PT. CLIFF CR. 430' N. & 600' W. FROM E 1/4 COR. SEC. 19
 DIV. PT. SHORT CR. 180' N. & 450' W. FROM E 1/4 COR. SEC. 19

FINAL PROOF SURVEY UNDER

R-40781 R-4567
 Application No. 40782 Permit No. 30390
 IN NAME OF

C.W. McDONOUGH

Surveyed OCT 17 1973, by R.G. MUCKEN