


T. 35 S.R.2W.W.M.

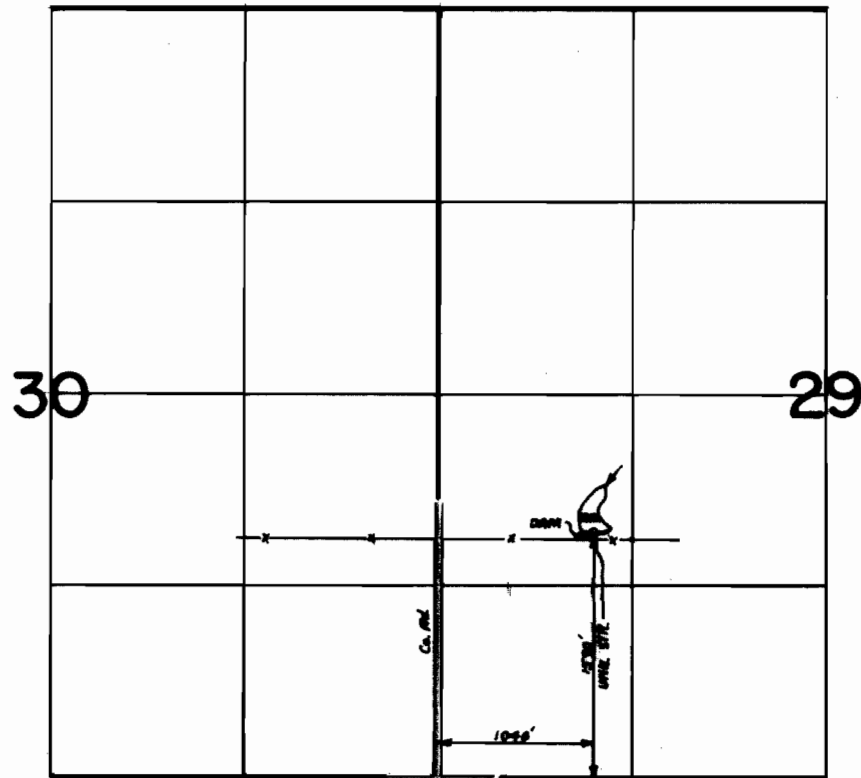

FINAL PROOF SURVEY
UNDER

Application No. R-48993 Permit No. R-5938
IN NAME OF

J. F. ETCHISON

Surveyed OCT 16 1973, by R.G. MUCKEN