


T.18S., R.4W., W.M.

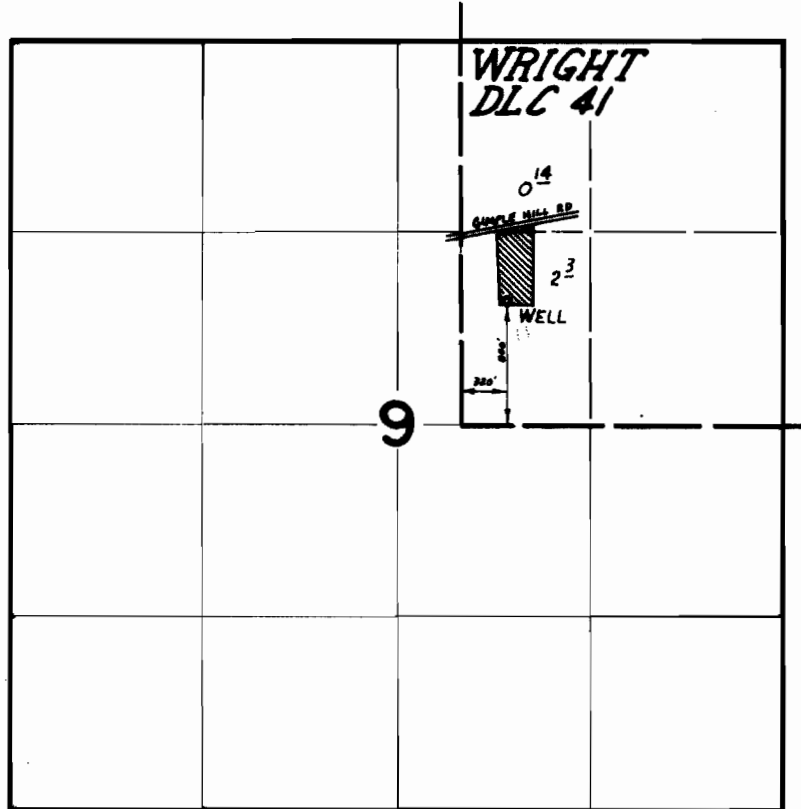

FINAL PROOF SURVEY
UNDER

Application No. G-4869 Permit No. G-4584
IN NAME OF

NORVAL or MARTHA JACKSON

Surveyed June 12 1973, by P. Norey