


T.16S.R.4W.W.M.

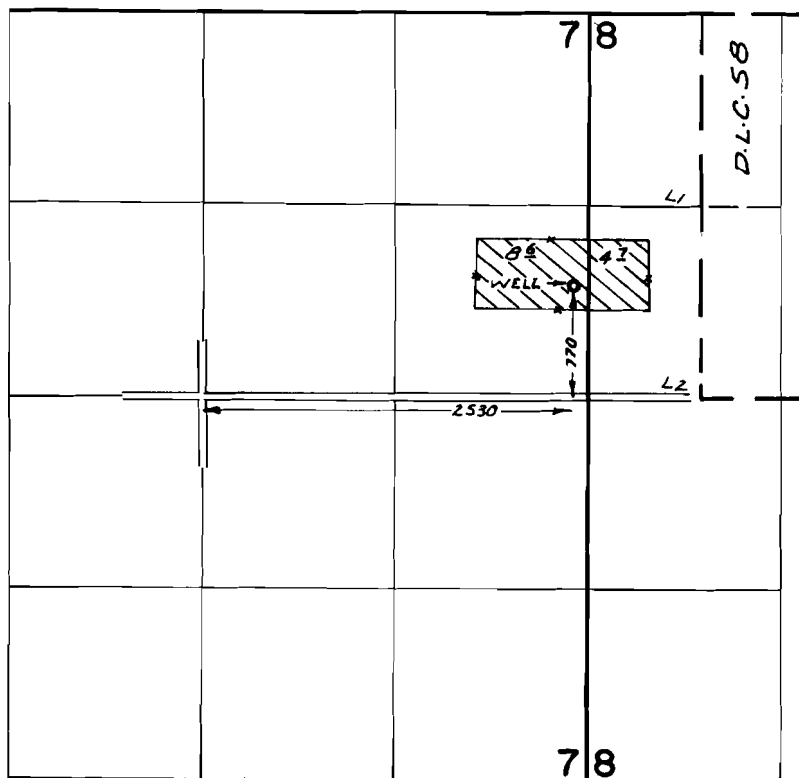

FINAL PROOF SURVEY
UNDER

Application No. G-5160 Permit No. G-4892
IN NAME OF

WALLACE & OPAL KRENK

Surveyed SEPT. 28, 1973, by R. MUGGEN