


T.16S.R.5W.W.M.

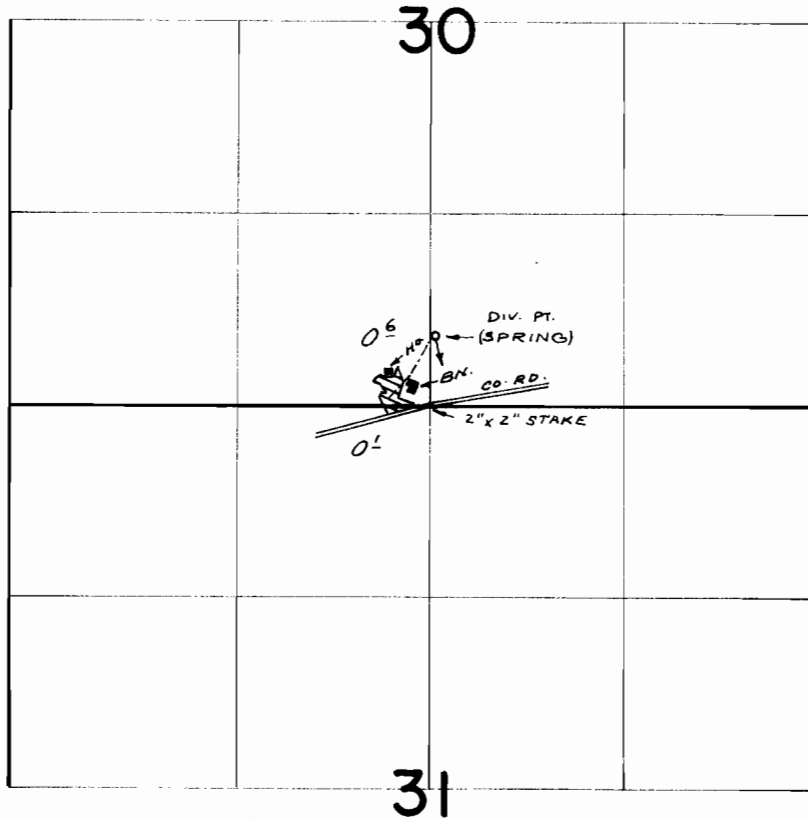

DIV. PT. LOC: 490' N & 30' E FROM S & COR. SEC. 30

FINAL PROOF SURVEY UNDER

Application No. 42486 Permit No. 31876
IN NAME OF

THOMAS G. SEXTON

Surveyed OCT. 4, 1973, by R. MUCKEN