


T.17S., R.3W., W.M.

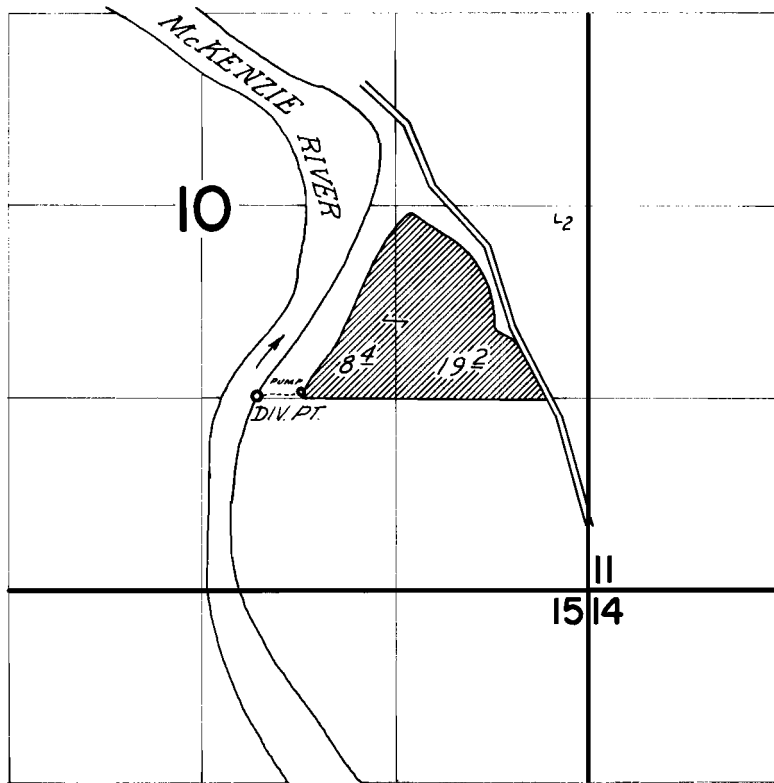

DIV. PT. LOCATED: 10' N & 370' E FROM SW COR NW ¼ SE ¼ SEC. 10

**FINAL PROOF SURVEY**  
UNDER

Application No. 44920 Permit No. 33575  
IN NAME OF

MARVIN L. ALLENDER

Surveyed May 3 19 73, by D. Nobby