


T.19 S.R.11W.W.M.

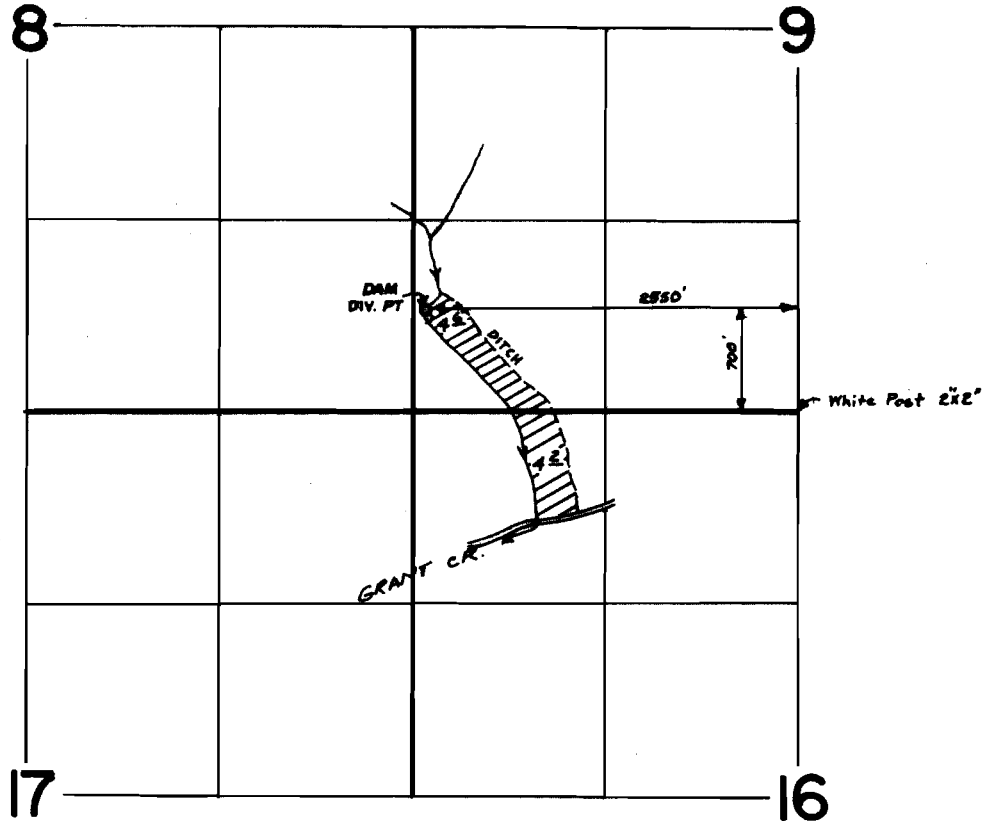

FINAL PROOF SURVEY UNDER

Application No. 45485 Permit No. 33848
IN NAME OF

VIRGIL R. AUSTIN

Surveyed JULY 19 1973, by L.E. GOULD