


T.17S.R.5W.W.M.

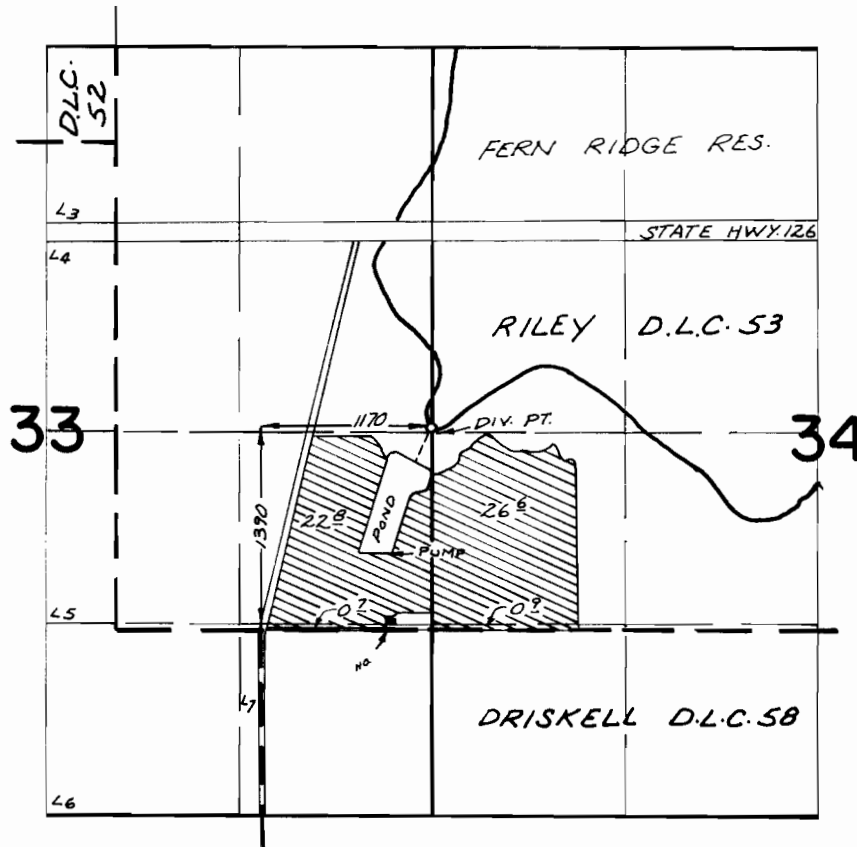

FINAL PROOF SURVEY
UNDER

Application No. 46899 Permit No. 35060
IN NAME OF

CHARLES R. SPORES

Surveyed SEPT. 7, 1973, by R. MUCKEN