


T.16S.R.6W.W.M.

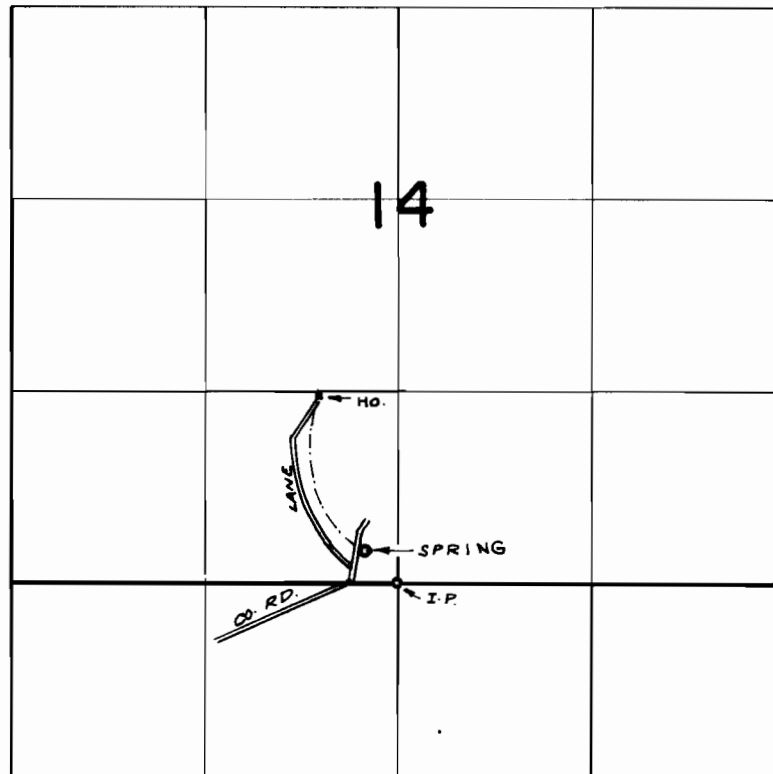

SPRING LOC: 220' N. & 220' W. FROM S $\frac{1}{4}$ COR. SEC 14

FINAL PROOF SURVEY
UNDER

Application No. 47936... Permit No. 35943...
IN NAME OF

GALE F. & RUBY I. FLETCHALL

Surveyed SEPT. 27 1973, by R. MUCKEN