


# T.18 S.R. 44 & 45 E.W.M.

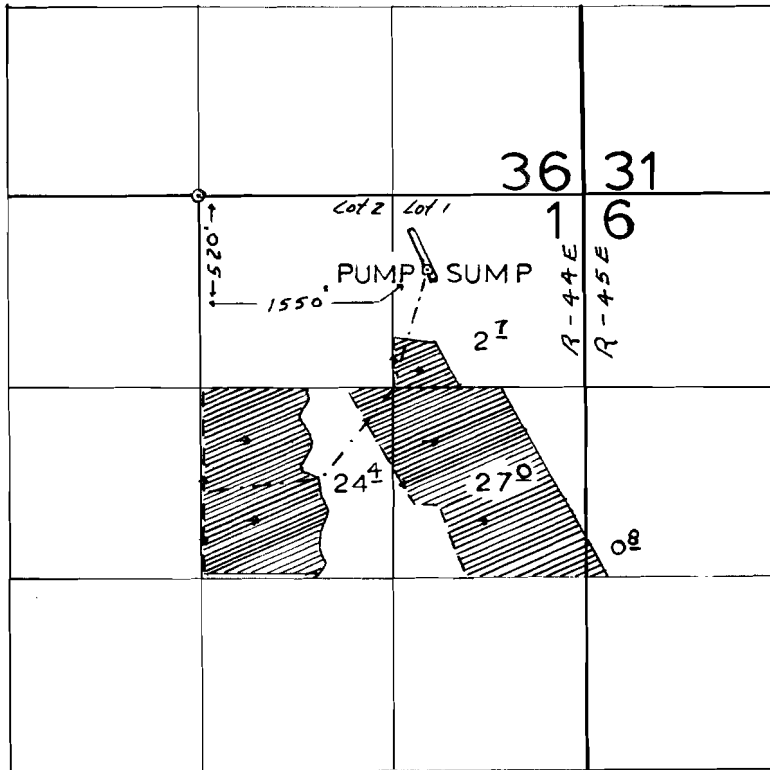

## FINAL PROOF SURVEY UNDER

Application No. G-5110 Permit No. G-4851  
IN NAME OF

RAYMOND BELNAP

Surveyed OCT. 11 1974, by F. ELFERING