


T.4S. R.1W. W.M.

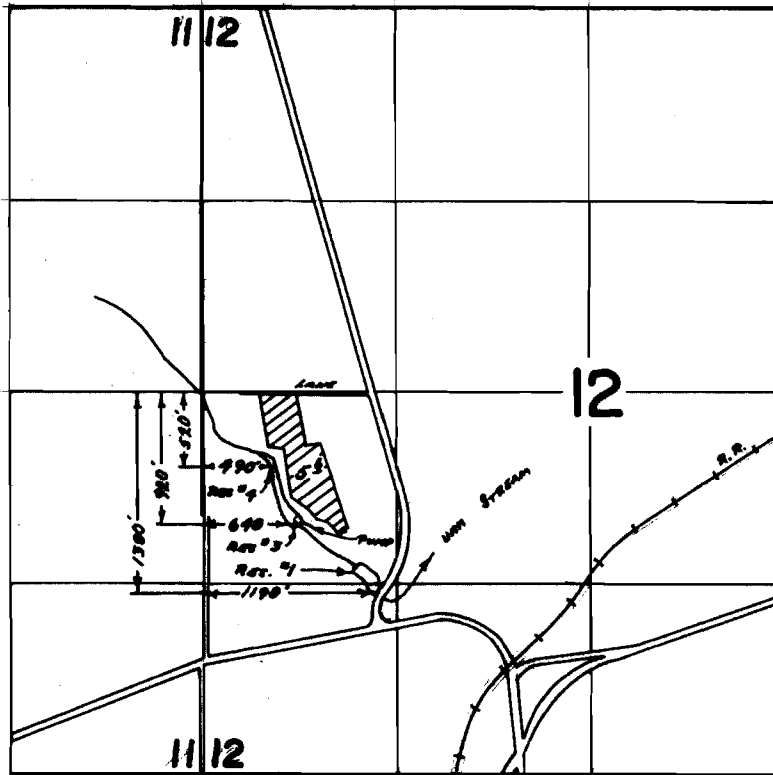

FINAL PROOF SURVEY UNDER

Application No. ⁴⁴⁵⁴²~~P-44541~~ Permit No. ³³³²⁶~~P-5275~~
IN NAME OF

RUDI KASEL

Surveyed MAY 25 1955, by T J PAUL