


T.1N. R.2E. W.M.

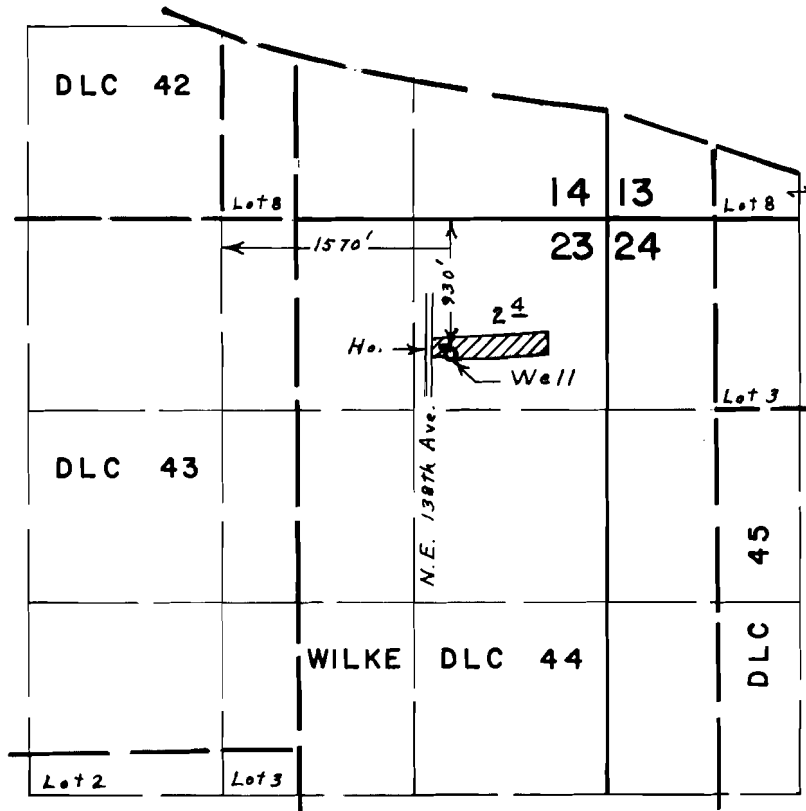

FINAL PROOF SURVEY
UNDER

Application No. G-4172 Permit No. G-3921

IN NAME OF

JOE GROSJACQUES

Surveyed May 11, 1973, by L. E. Gould.