


T. 1 N. R. 3 E. W.M.

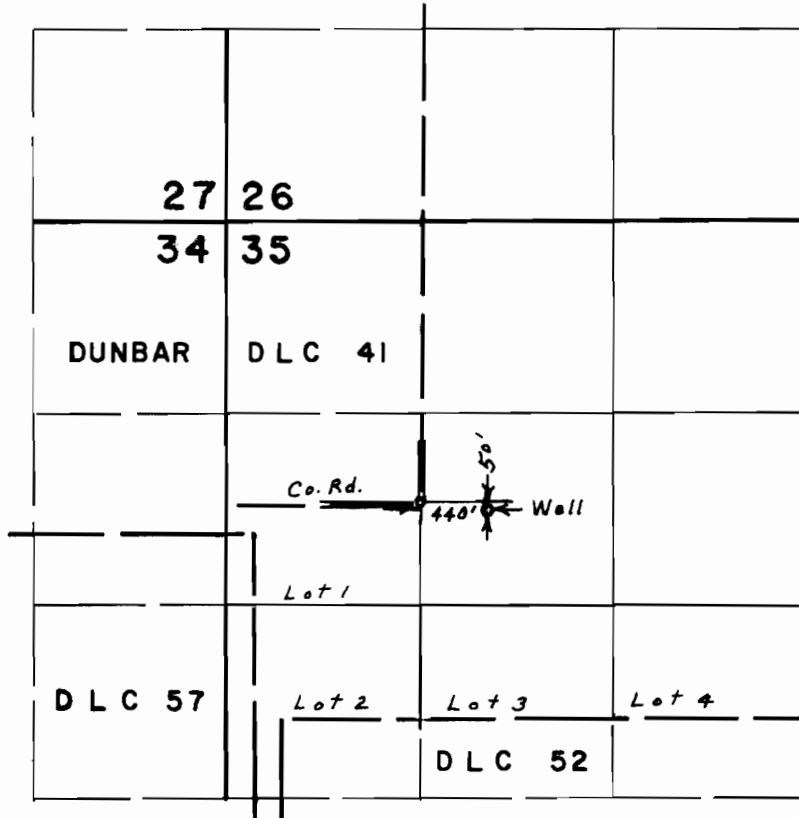

**FINAL PROOF SURVEY**  
UNDER

Application No. G-4428 Permit No. G-4172  
IN NAME OF

CITY OF WOOD VILLAGE

Surveyed May 8, 1973, by L. E. Gould