


T.1 S. R.5 E. W.M.

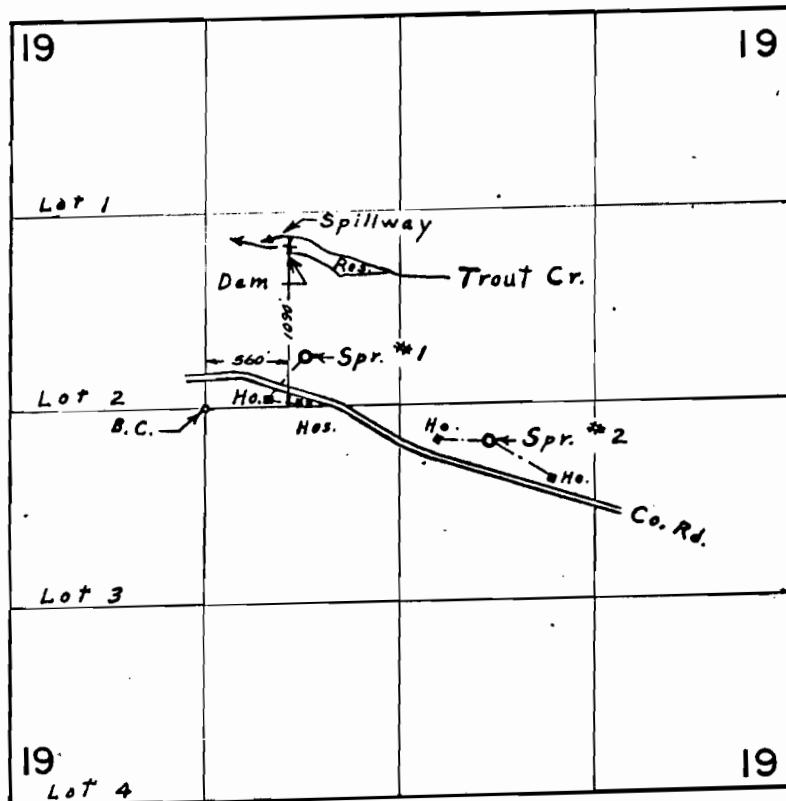

Springs located: #1, 340' N. & 600' E.; #2, 230' S. & 1920' E., both from S.W. Cor. S. E. & N. W. & Sec. 19

FINAL PROOF SURVEY

UNDER

R-41542 R-4678
41164 30969
Application No. 48336 Permit No. 36296..
IN NAME OF

BAKER BROTHERS

Surveyed Sept. 13 1974, by L. E. Gould..