T. 8 S. R. 6 W. W.M.

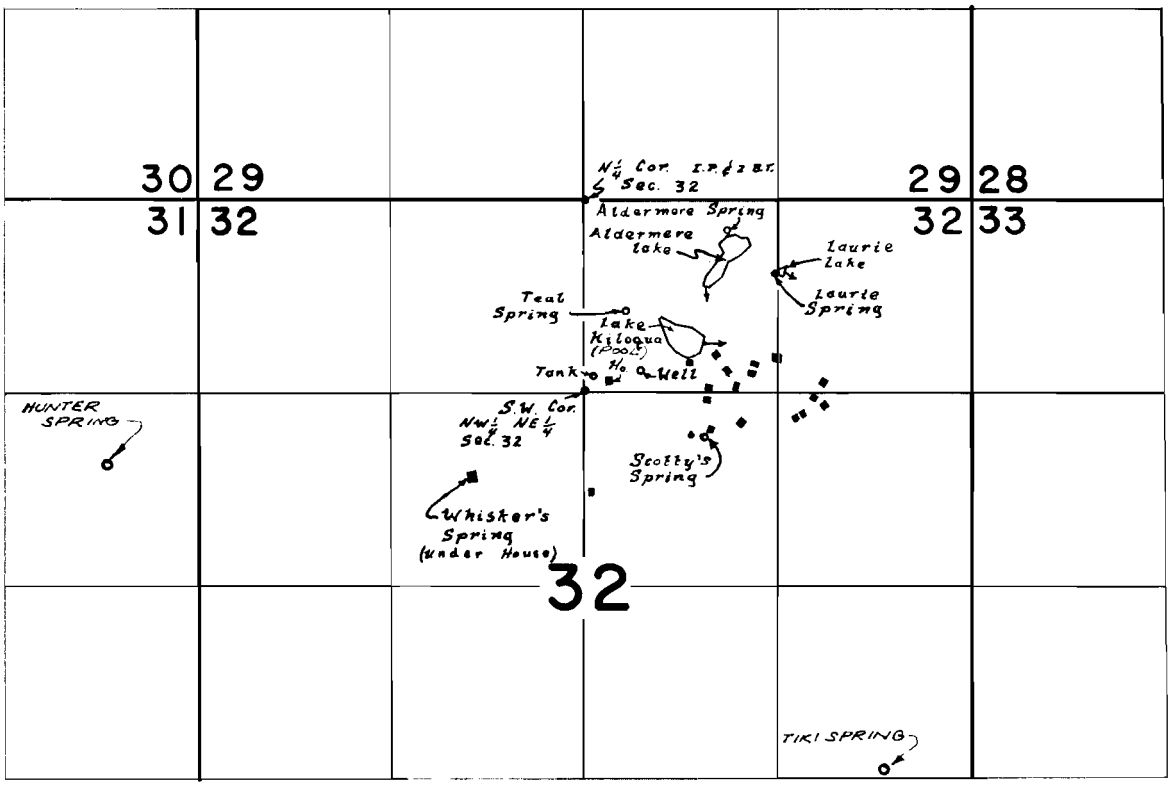

WHISKERS SPRING	1900' S. & 750' W.	All loc. from N.¼ Cor. Sec. 32
Aldermere Spring	210' S. & 980' E.	
" " Lake	600' S. & 840' E.	
Laurie Spring	510' S. & 1300' E.	
" " Lake	500' S. & 1380' E.	
Teal Spring	760' S. & 295' E.	
Well	1170' S. & 390' E.	
Lake Kiloqua	980' S. & 820' E.	
Scotty's Spring	1630' S. & 830' E.	
TIKI SPRING	3915' S. & 2050' E.	
HUNTER SPRING	1815' S. & 3270' W.	

FINAL PROOF SURVEY

UNDER

46907 35092
R-46908 R-5625
46909 35093

Application No G-5167 Permit No. G-4899

IN NAME OF

Willamette Council of Camp Fire Girls, Inc.

Surveyed 20 Nov. 1972, by L.E. Gould

1972-u U.E.O.