


T.9S. R.4W. WM.

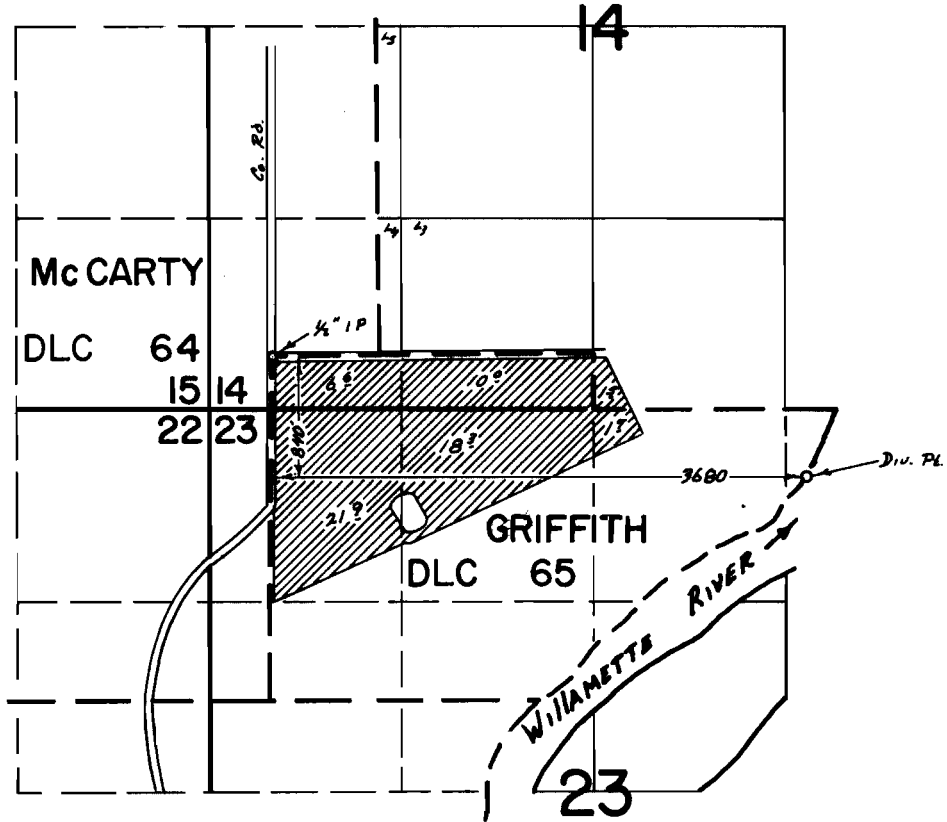

**FINAL PROOF SURVEY**  
UNDER

Application No. 41899 Permit No. 31368  
IN NAME OF

PERRY WELLS

Surveyed March 23 1973, by R.G. Mucken