


T. 9S. R. 5 W. W.M.

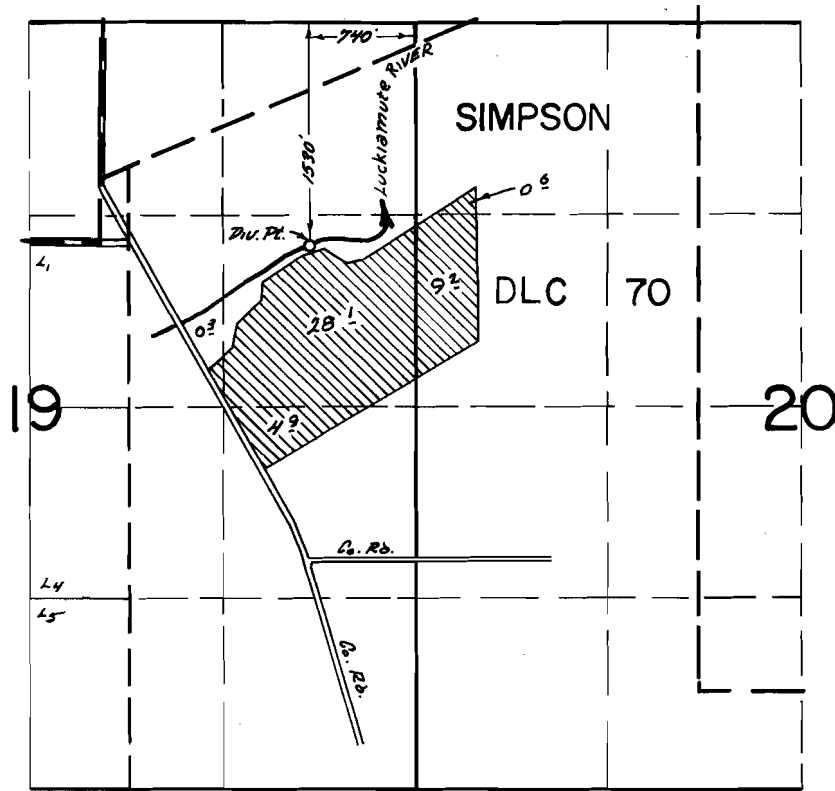

FINAL PROOF SURVEY
UNDER

Application No. 44226 Permit No. 93095

IN NAME OF

IVAN & CLEONE WILLIAMS

Surveyed March 23 1979 by R. G. Mucken