


T.8S. R.6W. W.M.

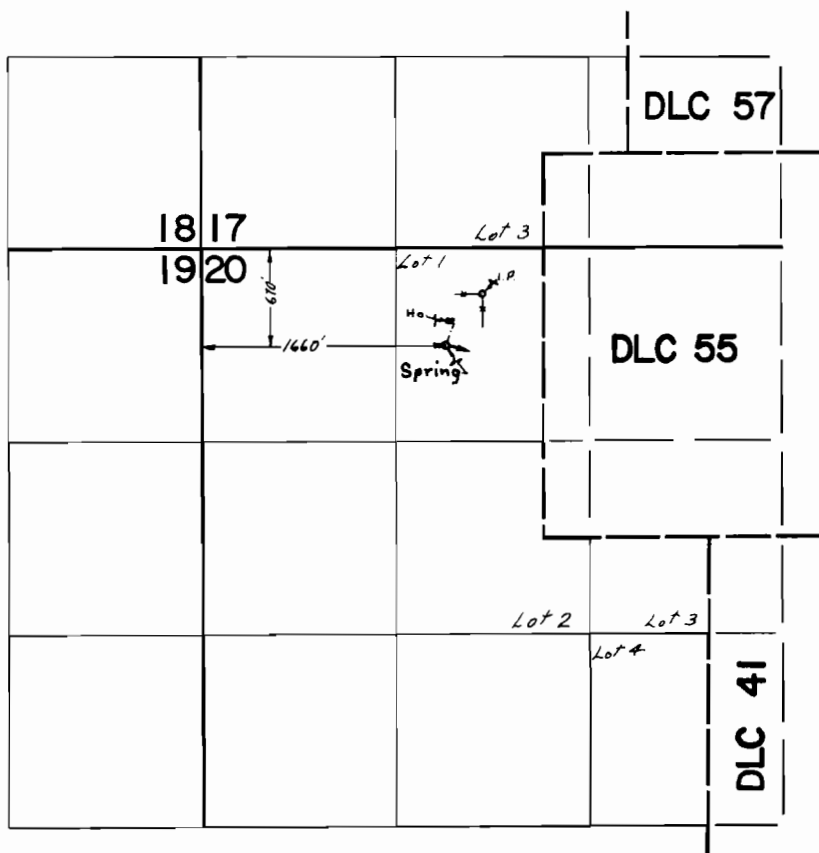

FINAL PROOF SURVEY
UNDER

Application No. 46541 Permit No. 34771
IN NAME OF

GEORGE R. FULTON

Surveyed APRIL 3, 1973, by R. MUCKEN