


T.8S. R.7W. W.M.

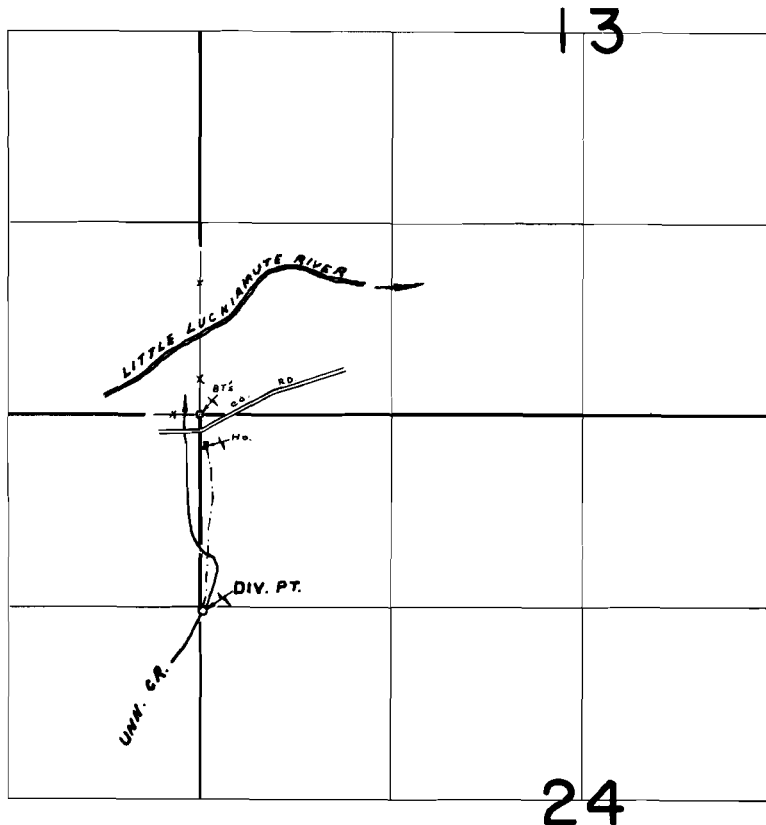

DIV. PT. LOC: 1350' S. & 30' E. from N.W. corner Section 24

FINAL PROOF SURVEY
UNDER

Application No. 47297 Permit No. 35439
IN NAME OF

EUGENE C. BROWN

Surveyed MARCH 30, 1973, by R. MUCKEN