


T.7S. R.5W. W.M.

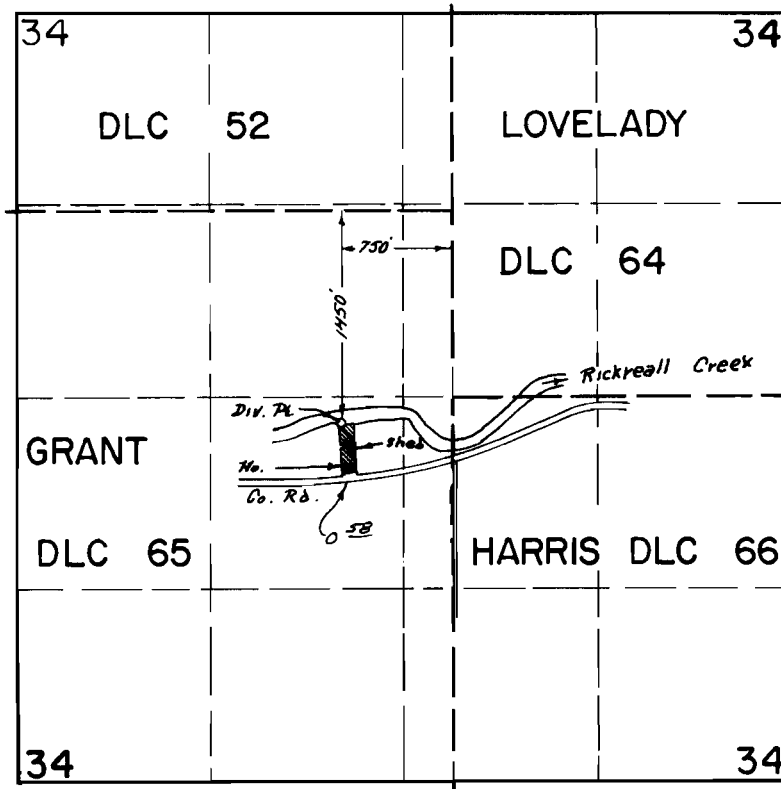

FINAL PROOF SURVEY
UNDER

Application No. 48055 Permit No. 36099
IN NAME OF

JOSEPH VAN WELL OR WHELEMINA VAN WELL

Surveyed April 5 1999 by R.G. Mucken