


T.9S. R.5W. W.M.

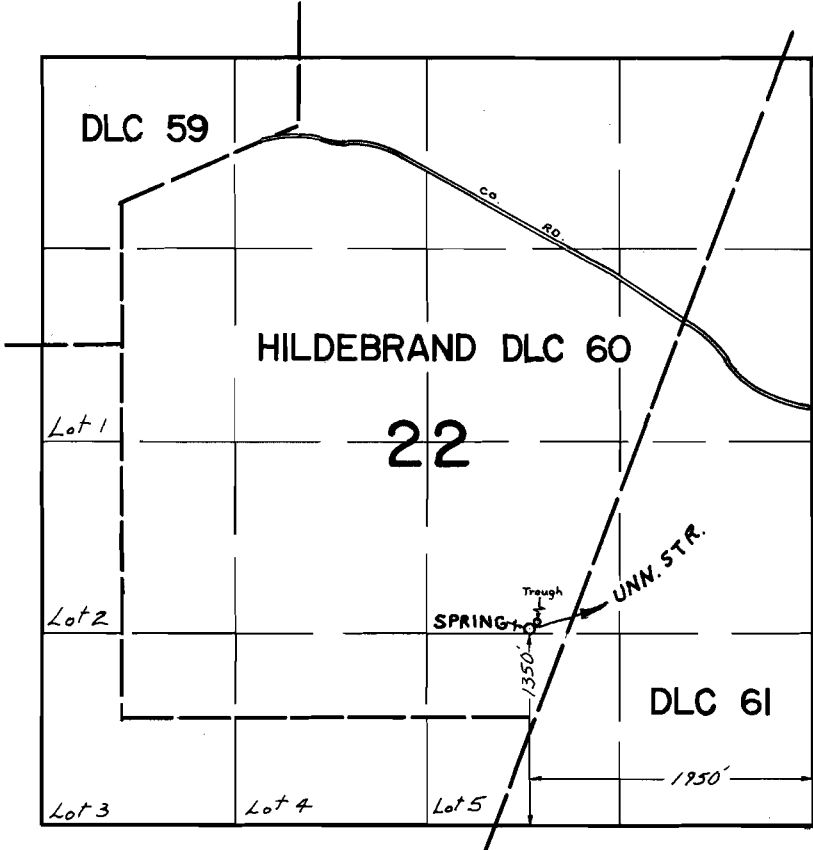

FINAL PROOF SURVEY
UNDER

Application No. 48377 Permit No. 36319
IN NAME OF

JOHN C. & DORTHY E. HEFFLEY

Surveyed MARCH 22, 1973, by R. MUCKEN