T.9S. R.4W. W.M.

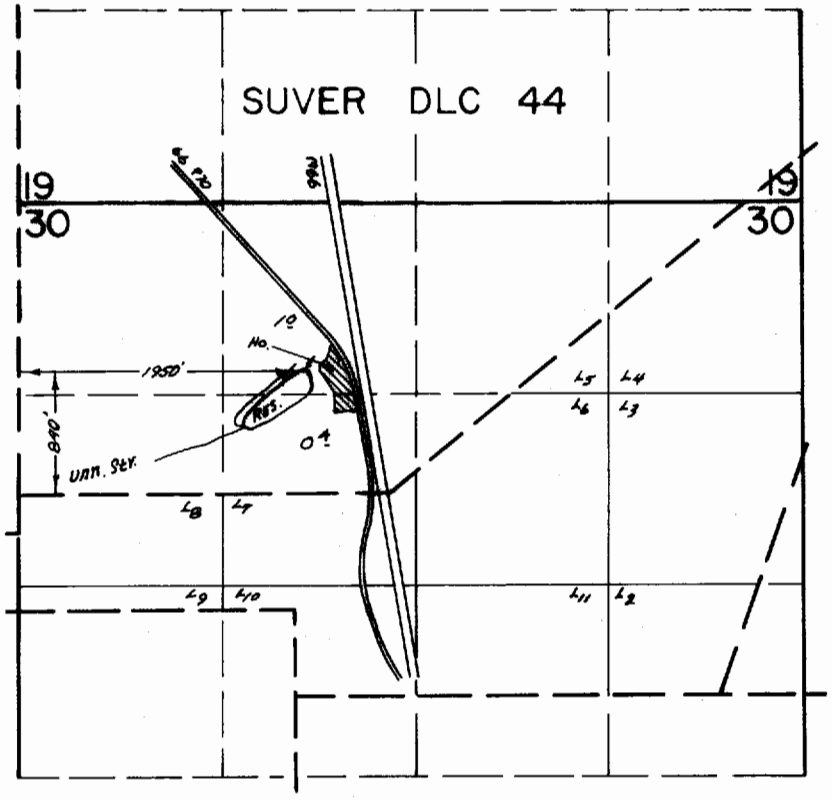

FINAL PROOF SURVEY
UNDER

Application No. R-42942 42943 Permit No. R-4879 32084

IN NAME OF

THOMAS & THELMA EASTMAN

Surveyed March 26 19 73, by R. G. Mucken

DFP-211-92 TP