


T.8S. R.5W. W.M.

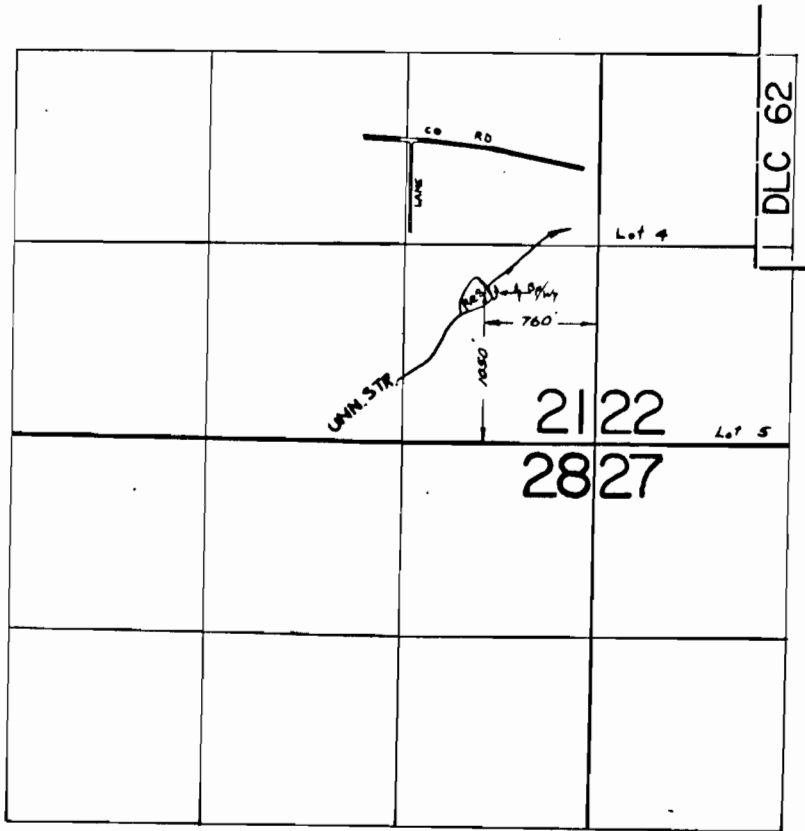

**FINAL PROOF SURVEY**  
UNDER

Application No. 46270 R-46269 Permit No. 34132 R-5425  
IN NAME OF

GERALD BAUMAN

Surveyed APRIL 3, 1973, by R. MUCKEN