


T.9S. R.4W. W.M.

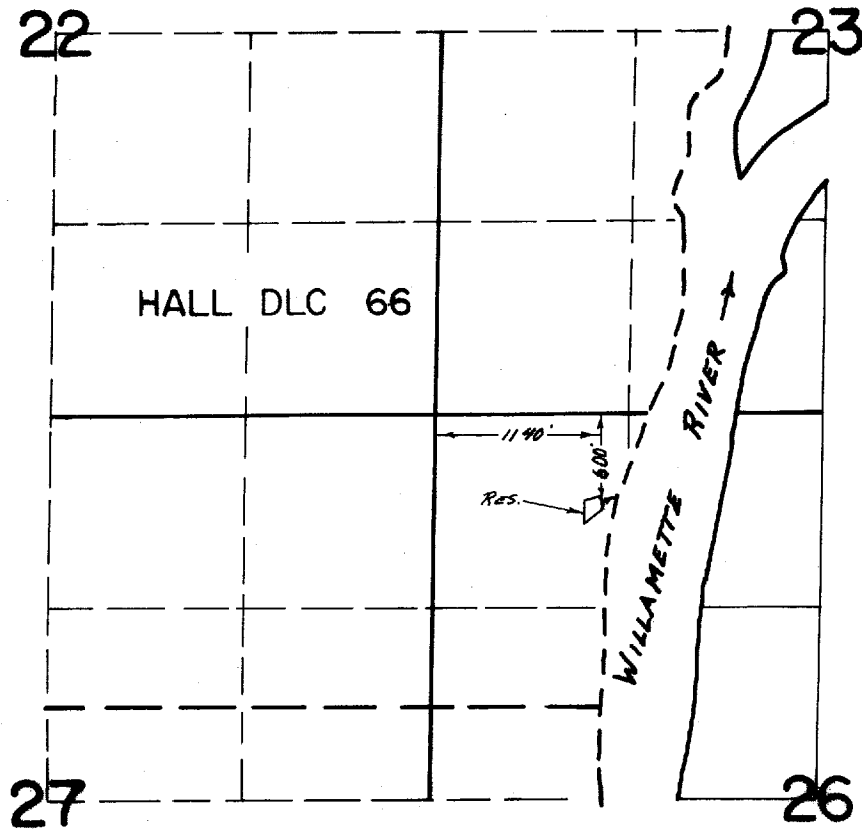

FINAL PROOF SURVEY
UNDER

Application No. ^{R-46394} 46395 Permit No. ^{R-5513} 34615
IN NAME OF

MRS. LEO DRAZDOFF

Surveyed March 23 19 73, by R.G. Mucken