


T. 8 S. R. 6 W. W.M.

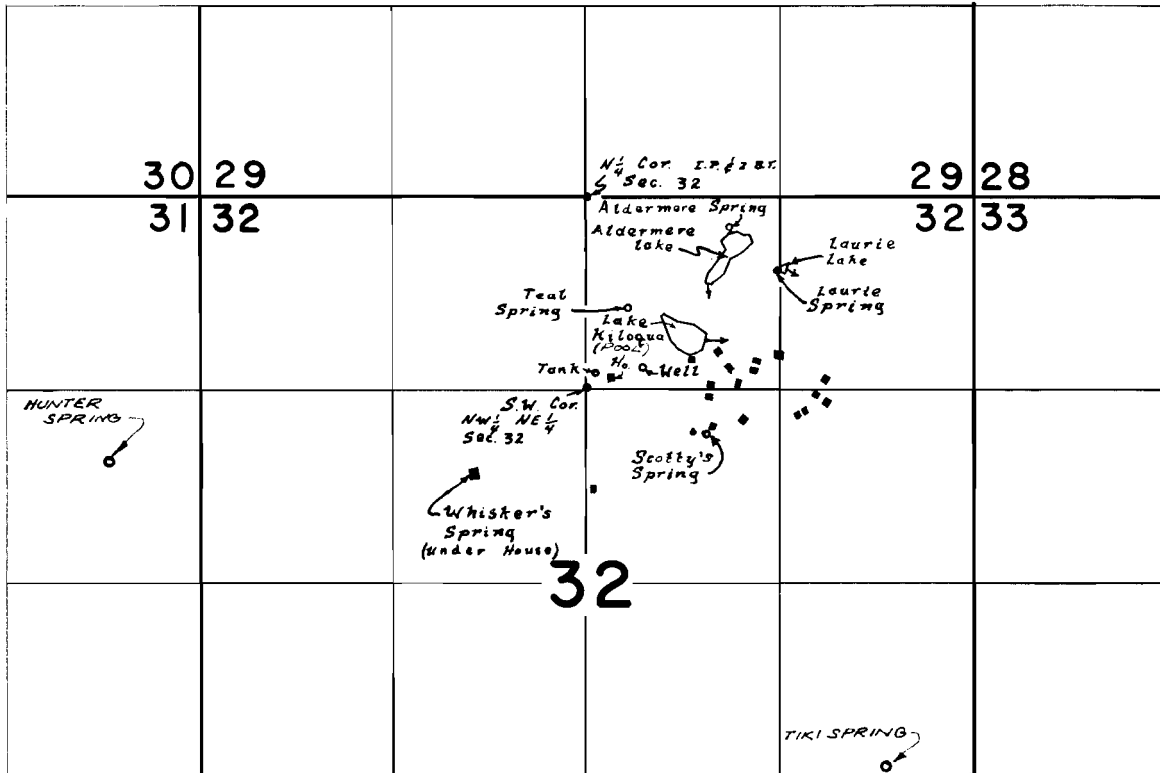

WHISKERS SPRING	1900' S & 750' W	} All loc. from N. 1/4 Cor. Sec. 32
Aldermere Spring	210' S & 980' E	
" " Lake	400' S & 840' E	
Laurie Spring	510' S & 1300' E	
" " Lake	500' S & 1380' E	
Teal Spring	760' S & 295' E	
Well	1170' S & 390' E	
Lake Kiloqua	980' S & 820' E	
Scotty's Spring	1630' S & 830' E	
TIKI SPRING	3915' S & 2050' E	
HUNTER SPRING	1815' S & 3270' W	

FINAL PROOF SURVEY
UNDER

46907 35092
R-46908 R-5625
46909 35093

Application No. G-5167 Permit No. G-4899

IN NAME OF
*Willamette Council of
Camp Fire Girls, Inc.*

Surveyed 20 Nov. 1972 by L.E. Gould