


T.2S.,R.44E.,W.M.

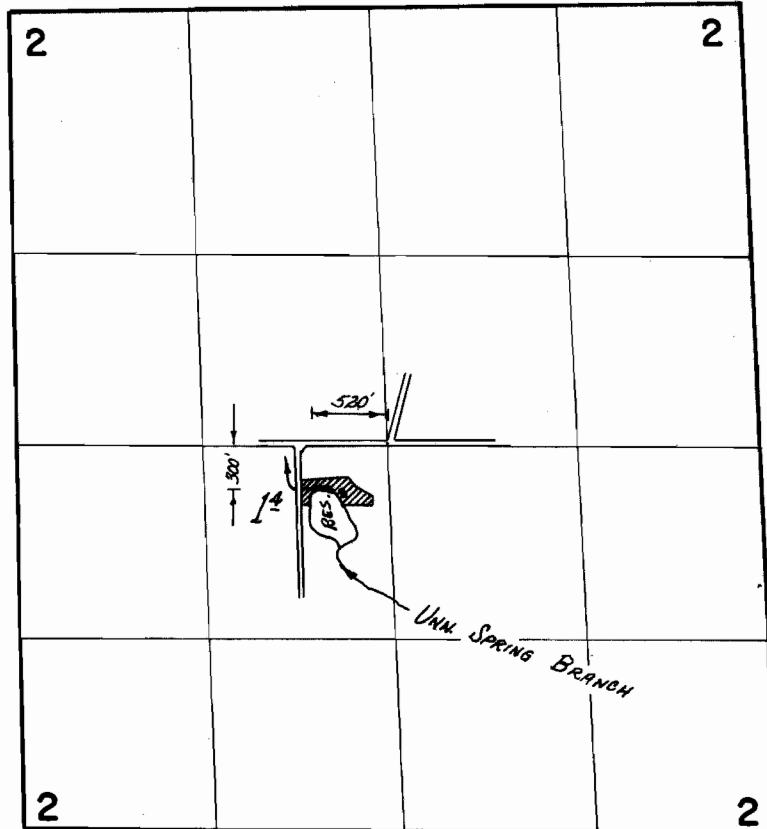

FINAL PROOF SURVEY
UNDER

R-48122 R-5851
Application No. 48123 Permit No. 36135
IN NAME OF

MICHAEL JON HENDRICKSON

Surveyed Aug. 8 19 73, by D. N. R. B.