


T.2S.,R.44E.,W.M.

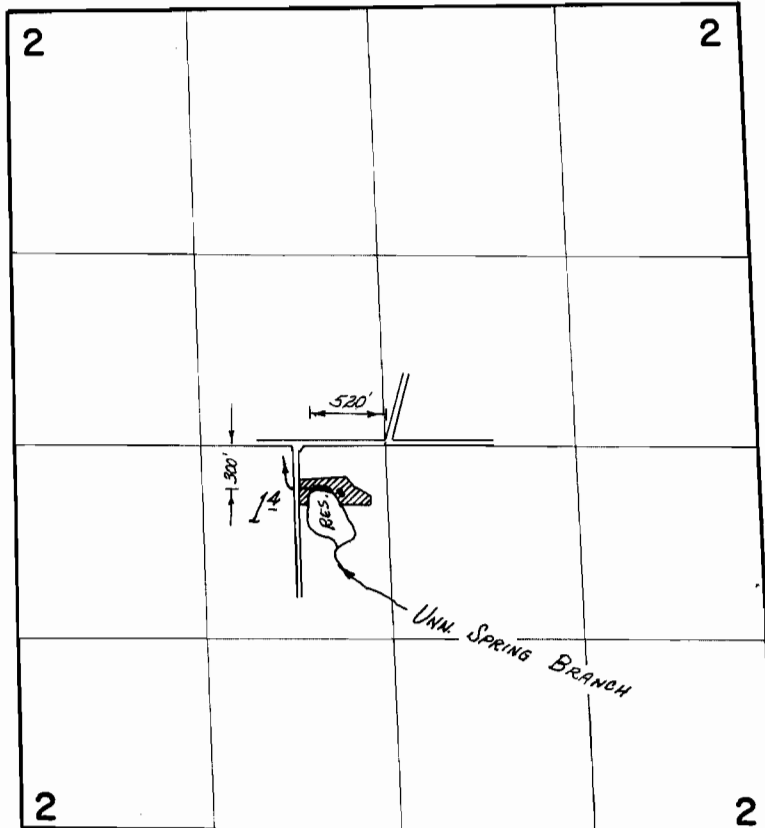

**FINAL PROOF SURVEY**  
UNDER

R-48122                      R-5851  
Application No. 48123    Permit No. 36135  
IN NAME OF

MICHAEL JON HENDRICKSON

Surveyed Aug. 8 19 73, by D. N. ...