


T.2S.3S. R.2W. W.M.

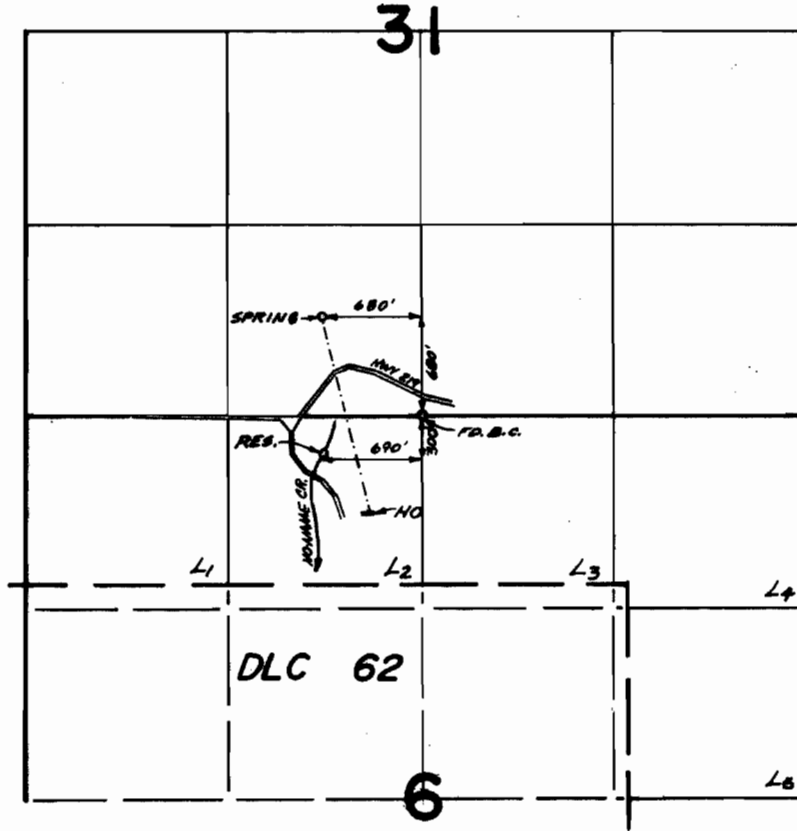

FINAL PROOF SURVEY
UNDER

R 49014 R 5774
Application No. 49015 Permit No. 35787
IN NAME OF

JOSEPH A. & MARITA GAY BRUGATO

Surveyed JULY 22, 1974, by L.M. TOLLE