


T.2&3S. R.2W. W.M.

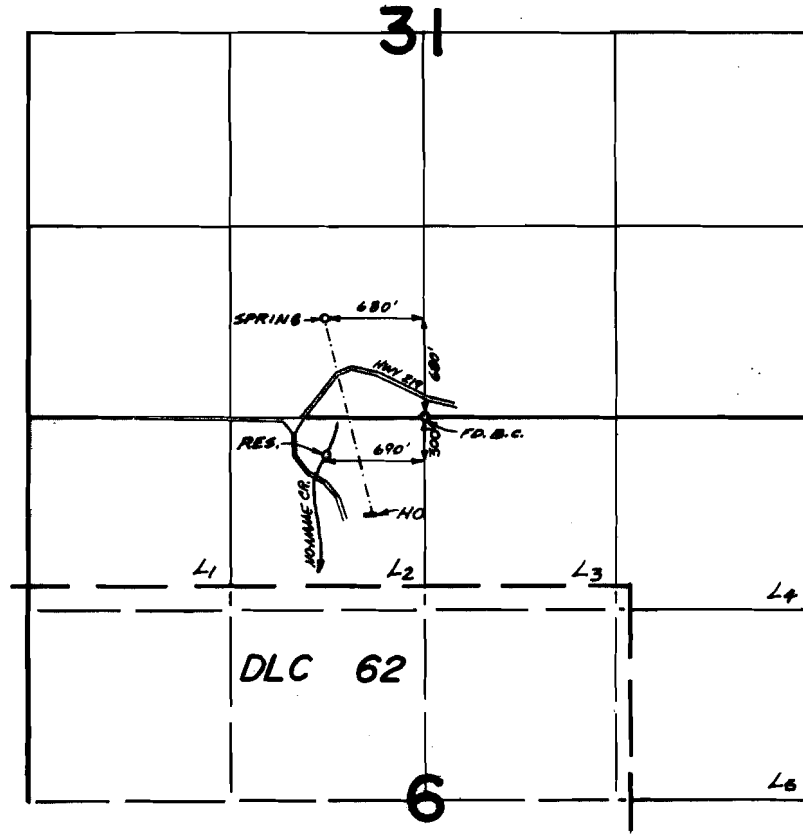

**FINAL PROOF SURVEY**  
UNDER

R 49014                      R 5774  
Application No. 49015    Permit No. 35787  
IN NAME OF

*JOSEPH A. & MARITA GAY BRUGATO*

Surveyed JULY 22, 1974, by ...L.M. TOLL.....