


T.2S.R.4-5E.W.M.

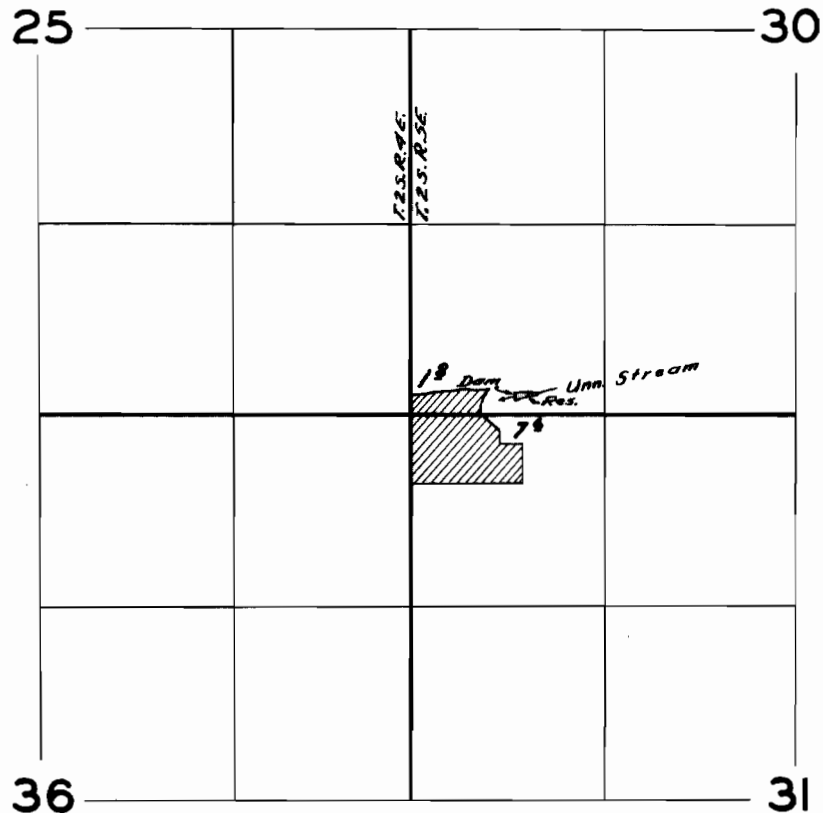

FINAL PROOF SURVEY

UNDER

Application No. *R-20048* Permit No. *R-784*
20049 *65616*

IN NAME OF

W. J. BLAKE

Surveyed *June 19*, 19*56*, by *R.H. Whitby*

DFK-4D-82

C.R.