


T. 3 S. R. 1 W. W. M.

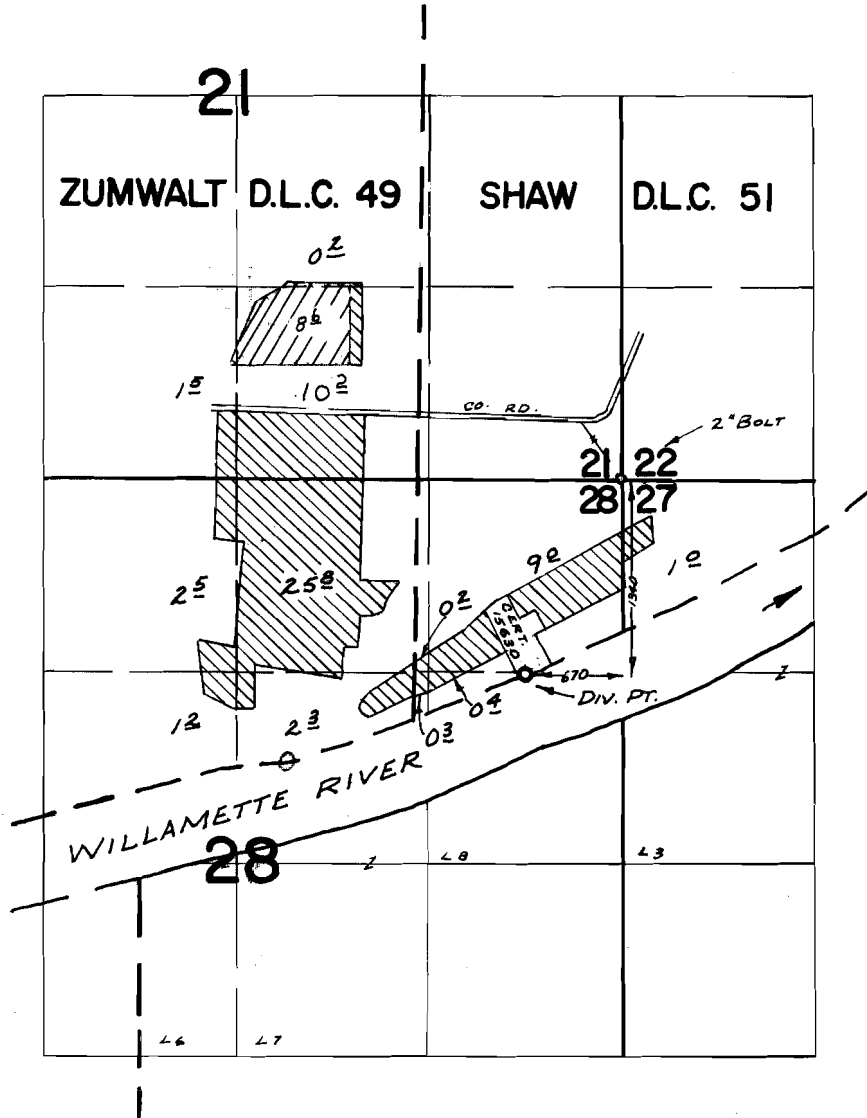

FINAL PROOF SURVEY UNDER

Application No. 48189 Permit No. 36197
43760 Permit No. 32703
 IN NAME OF



HARKSON FARMS, INC.

Surveyed JUNE 2, 1971, by R. MUCKEN