


T.27S.R.3W.W.M.

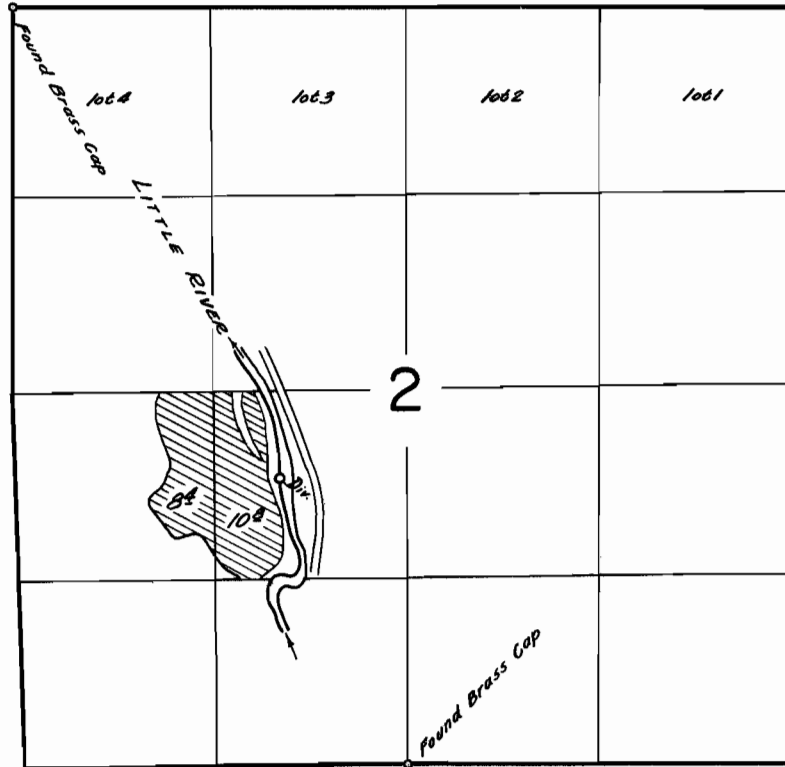

FINAL PROOF SURVEY
UNDER

Application No. 37306 Permit No. 27792
IN NAME OF

Ernest F. Roglitz

Surveyed March 2 1963, by C.O. Bartels