


T.33S.R.2E.W.M.

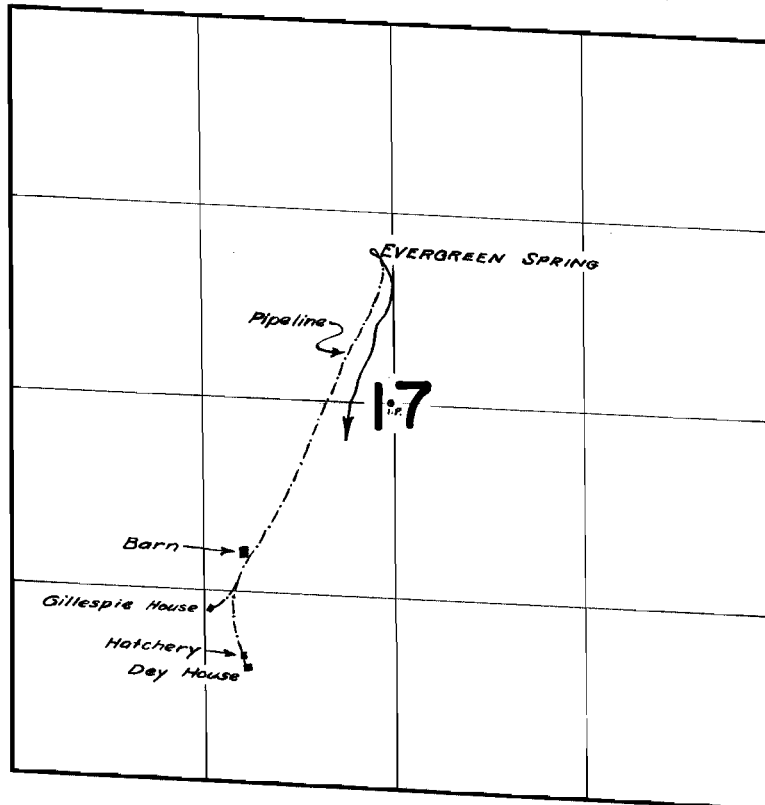

FINAL PROOF SURVEY UNDER

Application No. **30933** Permit No. **24345**
IN NAME OF

RUTH B. DEY & ELLA A. GILLESPIE

Surveyed May 17, 1963, by *A. Jackson*