


T.36S. R.3W. W.M.

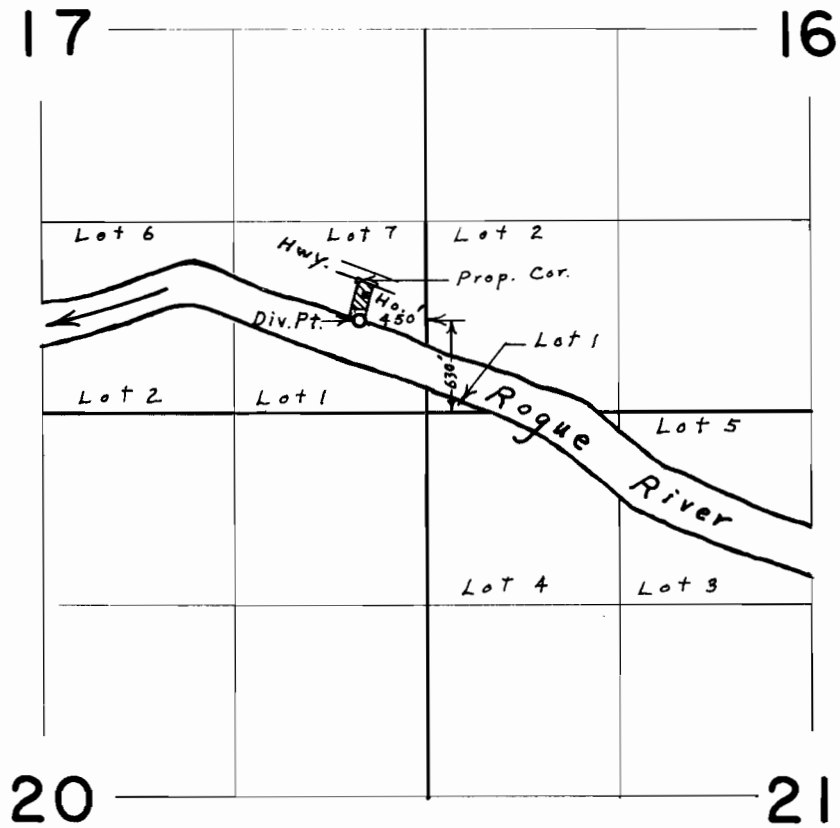

FINAL PROOF SURVEY
UNDER

Transfer No. 2615
Application No. Permit No.
IN NAME OF

BERNICE SHANABROOK

Surveyed Sept. 29, 1973, by L. E. Gould