


T. 6 S. R. 1 E. W. M.

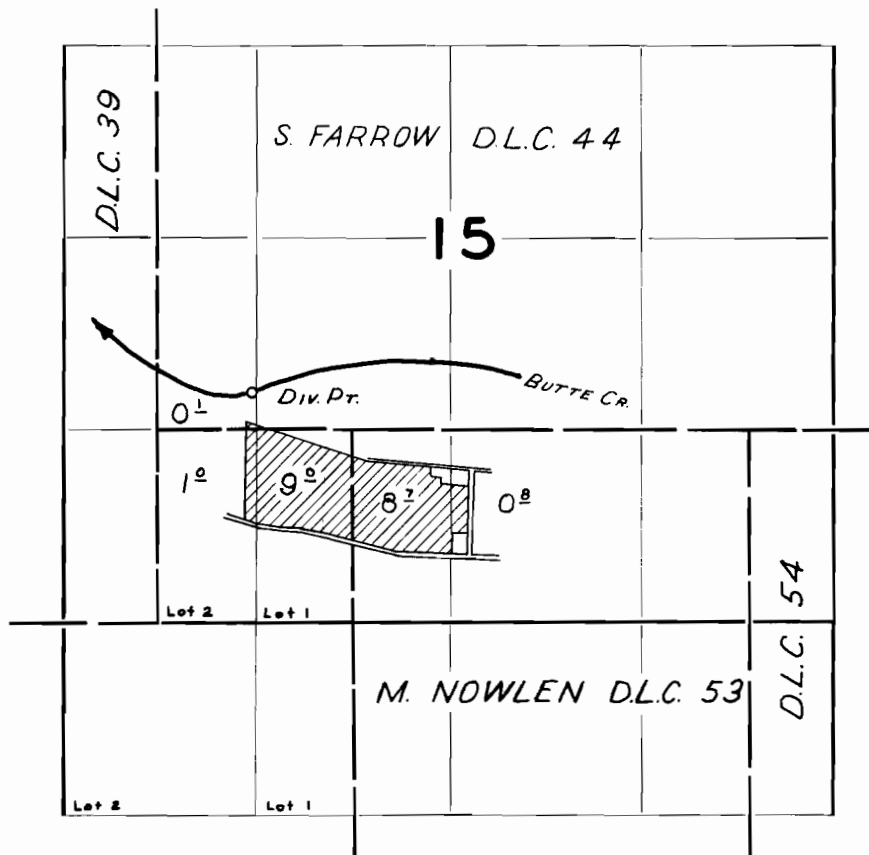

FINAL PROOF SURVEY UNDER

Application No. 37876 Permit No. 28228
IN NAME OF

ARTHUR ROSENBLAD

Surveyed JUL 16 1964, by R. JACKSON