


T. 7. S. R. 1 & 2 W. W.M.

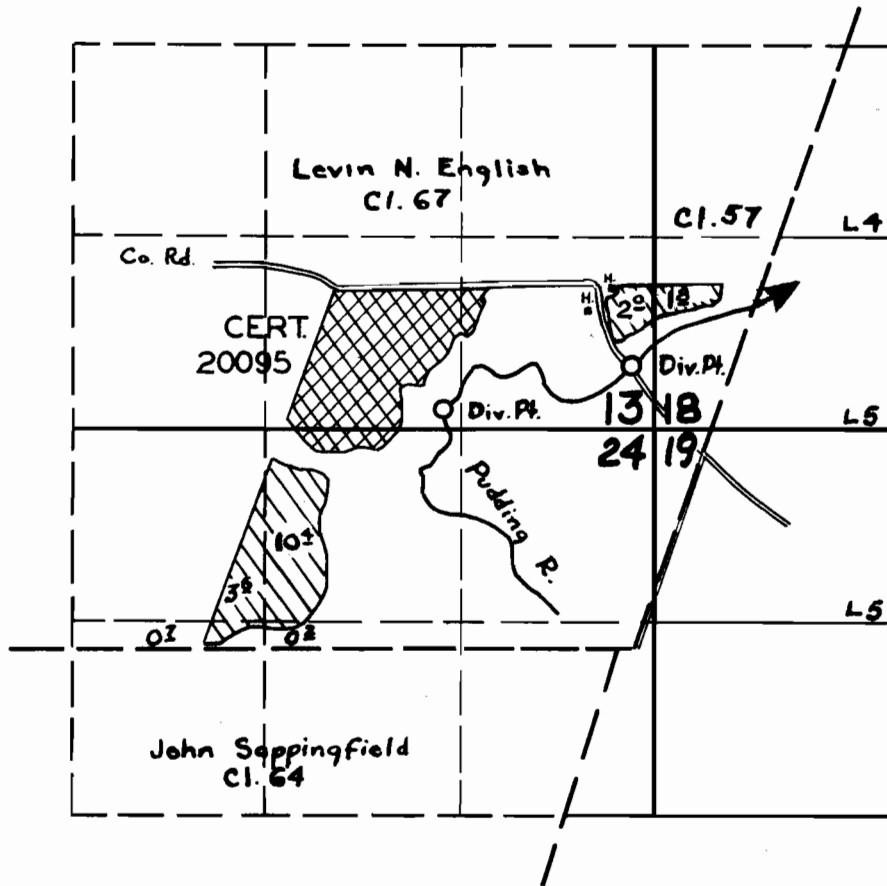

**FINAL PROOF SURVEY**

UNDER

Application No. 24086 Permit No. 18968

IN NAME OF

CORNELIUS BATESON

Surveyed 27 Feb. 1956, by M. Bish