


T.7S.R.2 W.W.M.

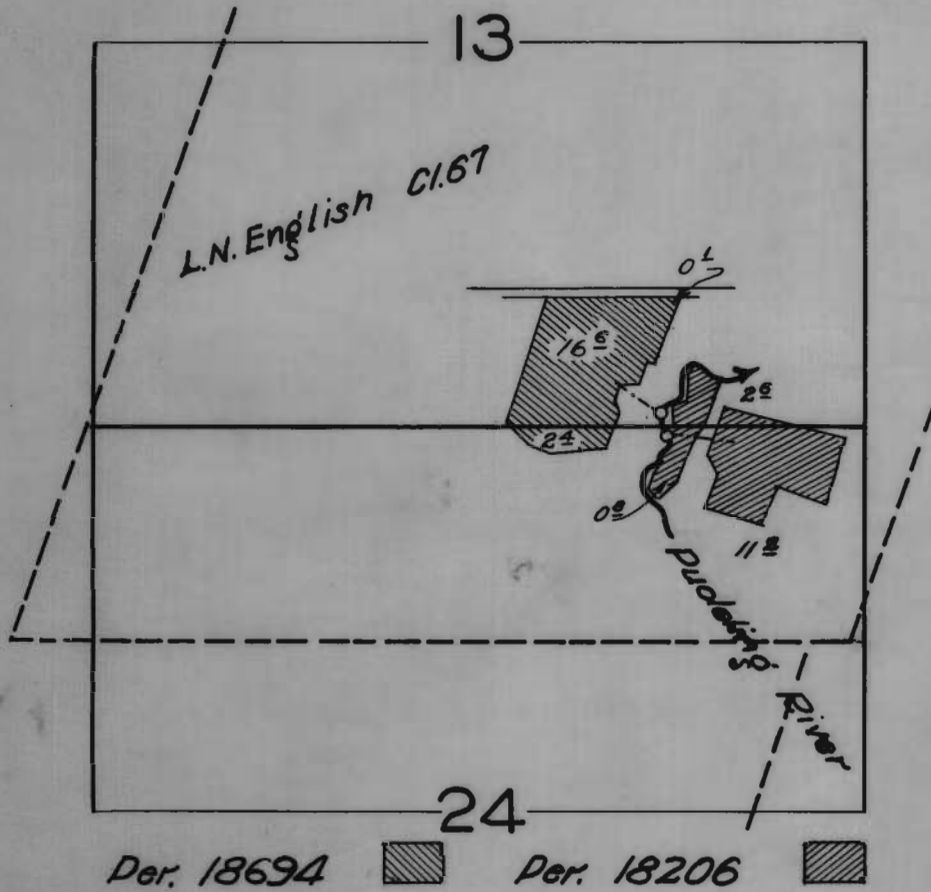

FINAL PROOF SURVEY

UNDER

23070

18206

Application No. 23645 Permit No. 18694

IN NAME OF

CORNELIUS BATESON & ALBERT SCHARER

Surveyed August 8 1952, by H. L. COFFMAN