


T.18S. R. 5W.W. M.

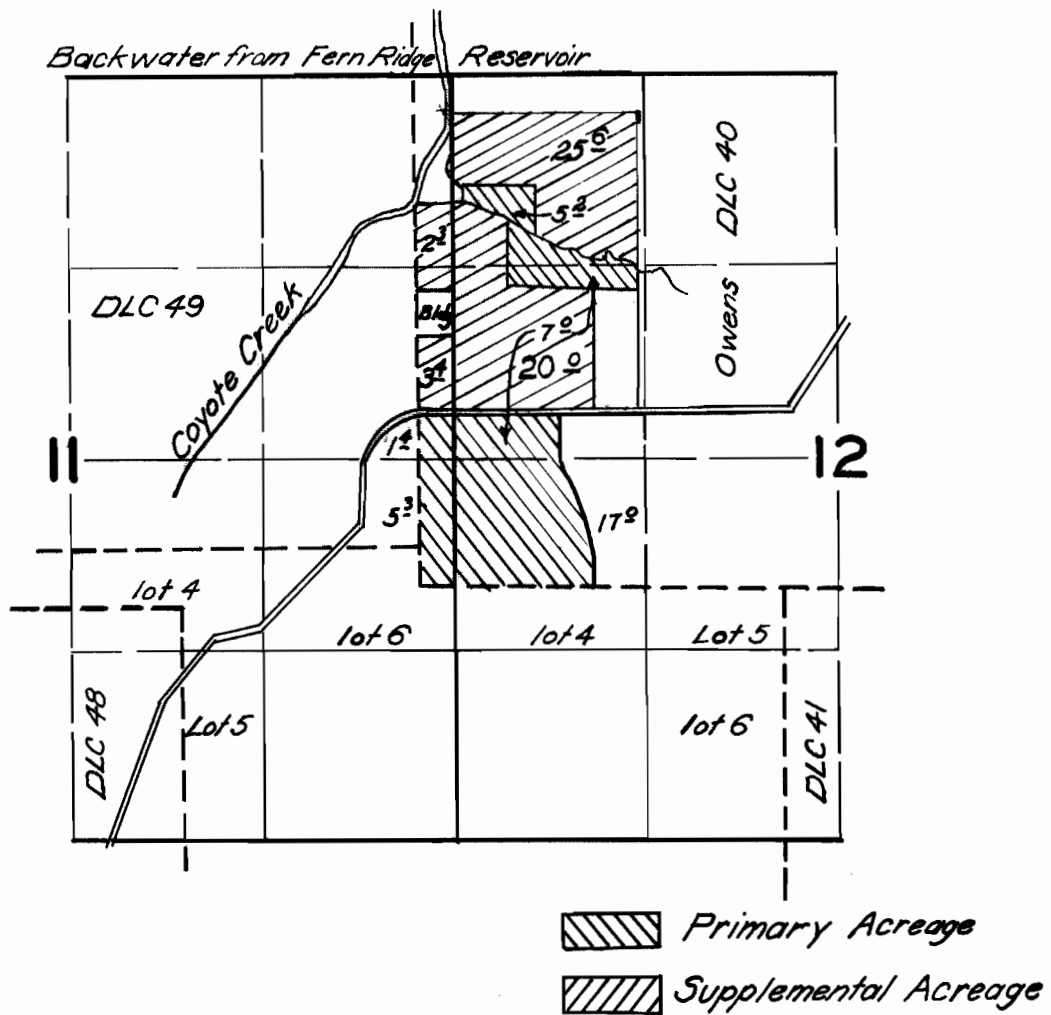

FINAL PROOF SURVEY UNDER

Application No. 33757... Permit No. 26681...
IN NAME OF

Eugene E. Platt

Surveyed May 9... 1962, by Carl R. Baker