


T. 10 S., R. 10 W. W.M.

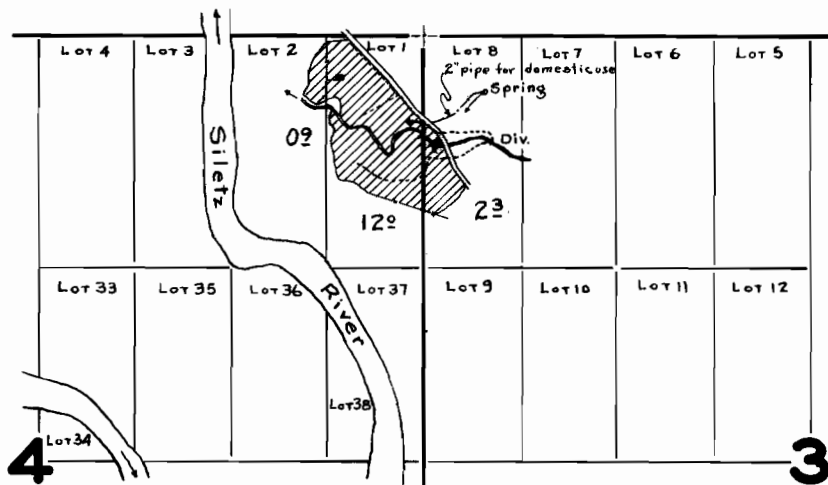

FINAL PROOF SURVEY UNDER

Application No. 15253 Permit No. 11391

IN NAME OF

D. A. & Paul B. Morton

Surveyed Sept. 10, 1942, by Geo. O. Pederman