


T.13S. R.2E.W.M.

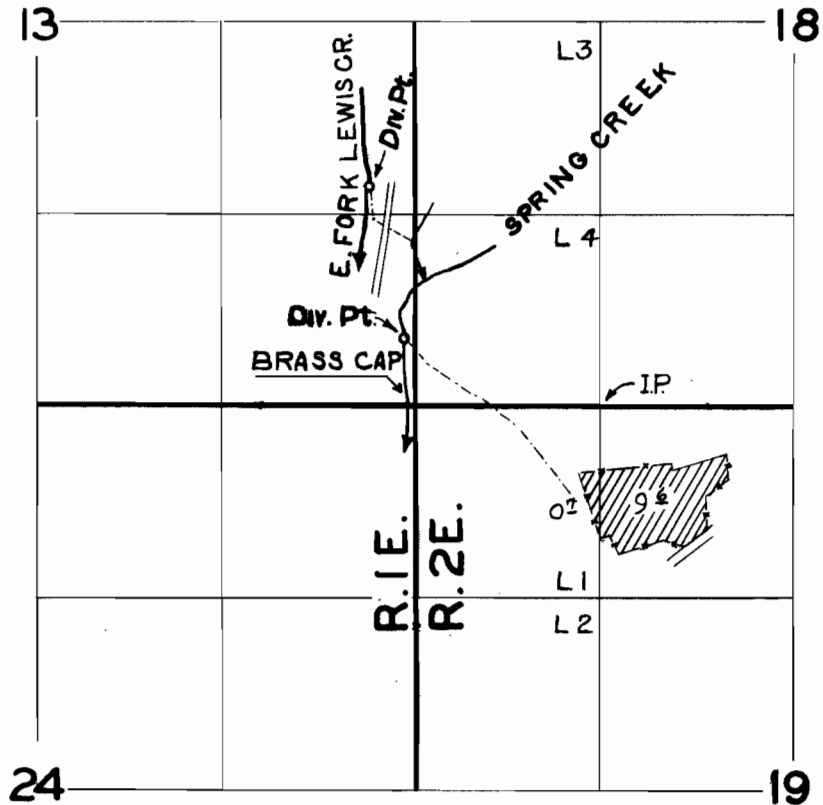

FINAL PROOF SURVEY
UNDER

Application No. 28564. Permit No. 22514...
IN NAME OF

.....HERBERT HUGHES.....

Surveyed MAY 10, 1960, by M. BISH.....