


T. 2 N. R. 3 & 4 W. W. M.

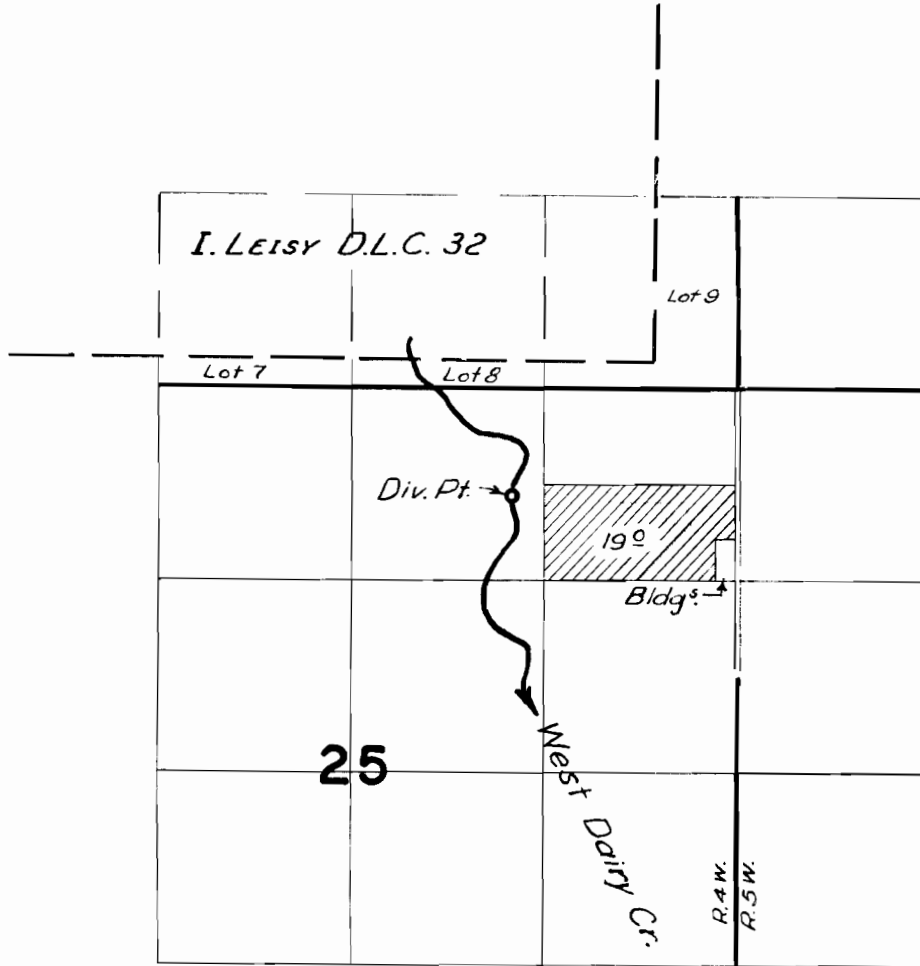

FINAL PROOF SURVEY
UNDER

Application No. 34614 Permit No. 27179.
IN NAME OF

VERLE E. PRICKETT

Surveyed 3 July 1962, by M. Bish