


# T. 2 S. R. 2 W. W. M.

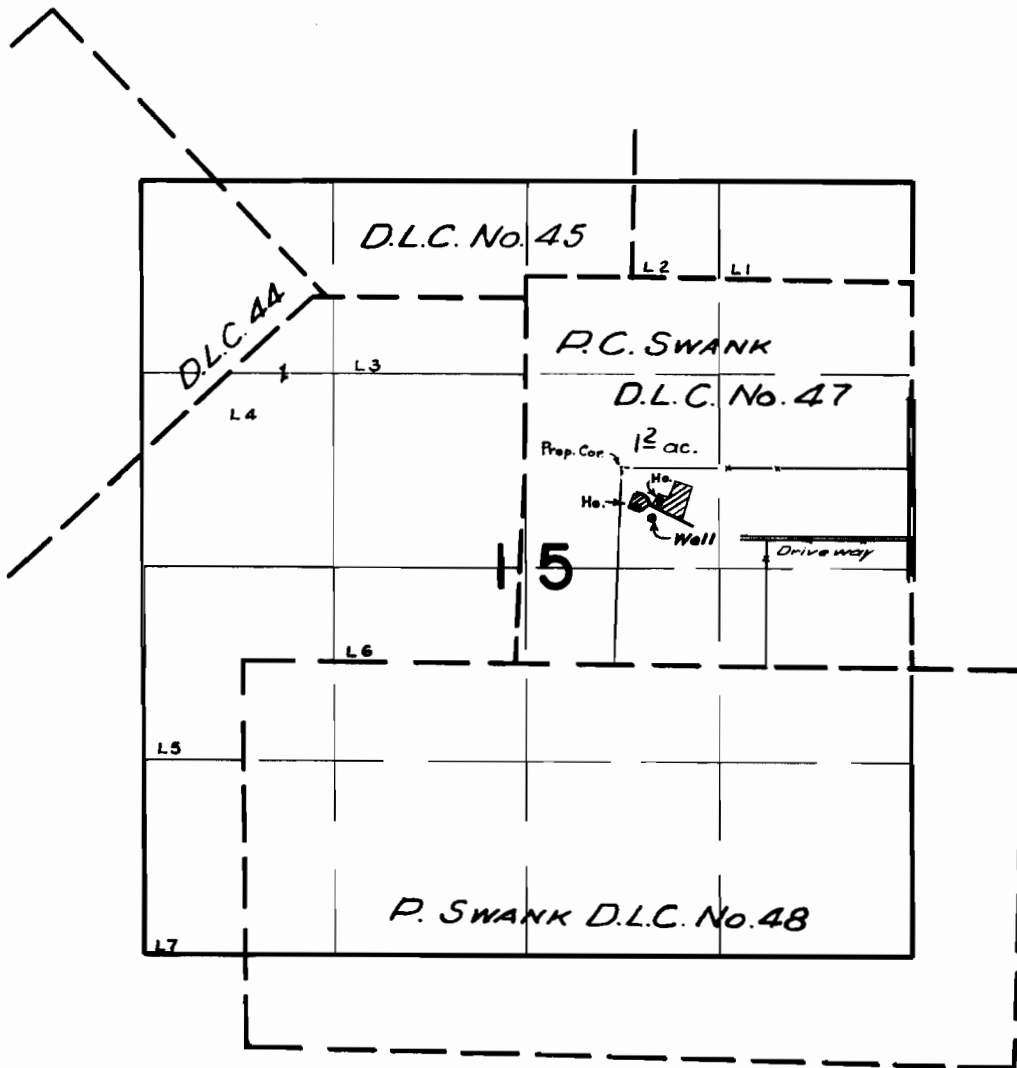

## FINAL PROOF SURVEY UNDER

Application No. G-1430 Permit No. G-1330  
IN NAME OF

GABRIEL PASCUZZI

Surveyed Aug. 1 1963, by M. Bish