


T.4 S. R.3W.W.M.

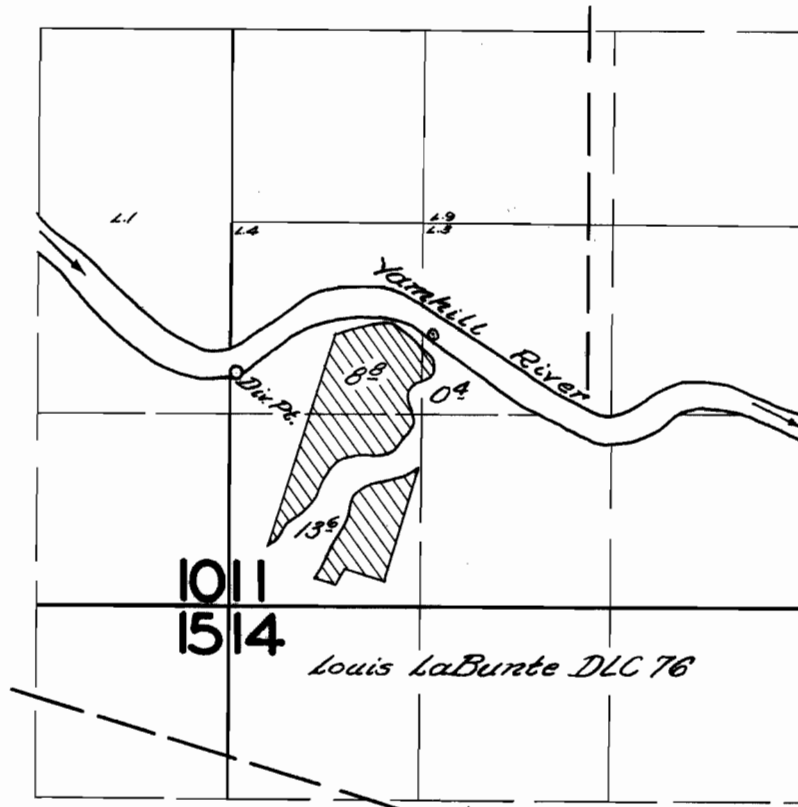

FINAL PROOF SURVEY UNDER

Application No. 29223 Permit No. 22953
IN NAME OF

Thomas Owens

Surveyed June 4 1958, by M. Bish