


T. 5S. R. 6W. W.M.

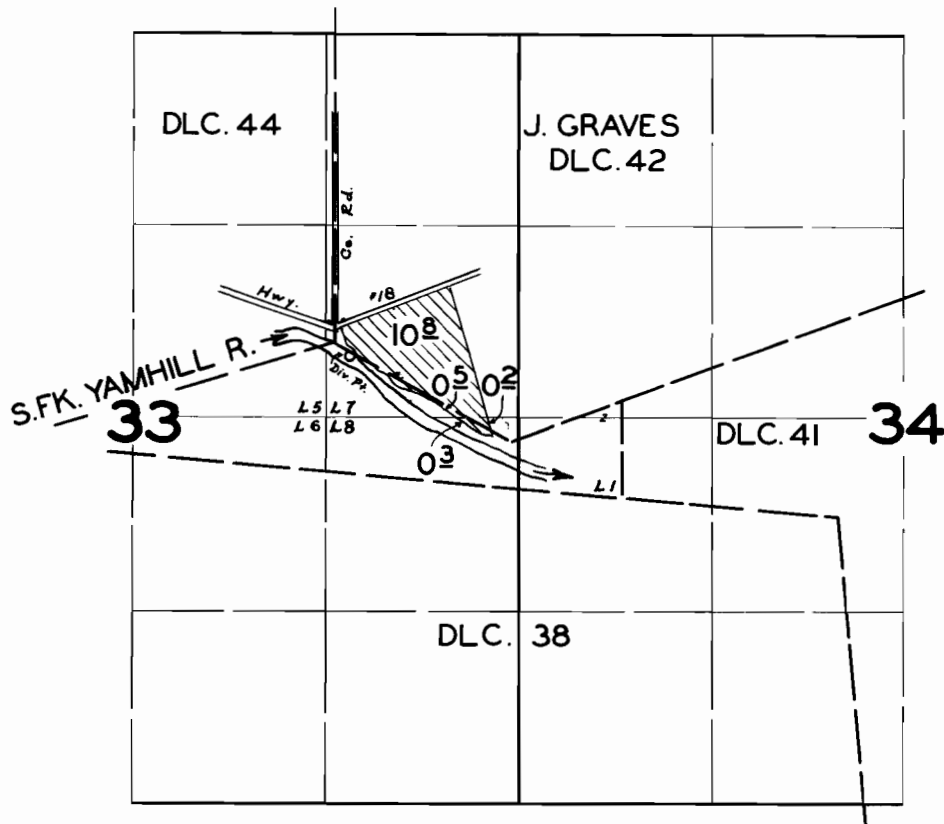

**FINAL PROOF SURVEY**  
UNDER

Application No. 29049 Permit No. 22850  
IN NAME OF

**JOHN R. UMFRED**

Surveyed APR. 10 1958 by M. BISH