


T.36S.R.1E.W.M.

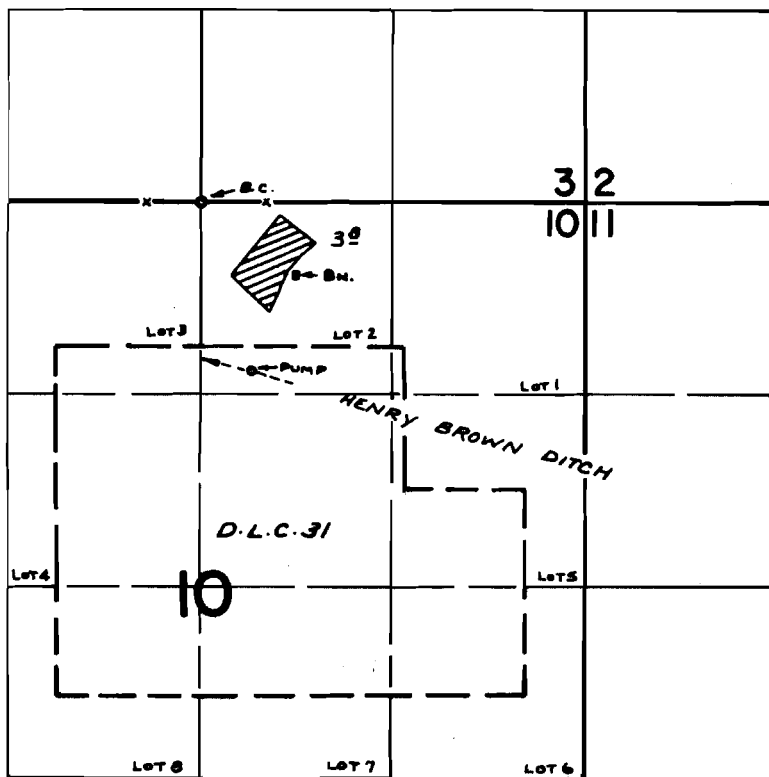

FINAL PROOF SURVEY UNDER

TRANSFER NO. M-178

Application No. Permit No.
IN NAME OF

..... MERTON BRADSHAW CO.

Surveyed JUNE 5, 1974, by R. MUCKEN