


T.11S., R.4W., W.M.

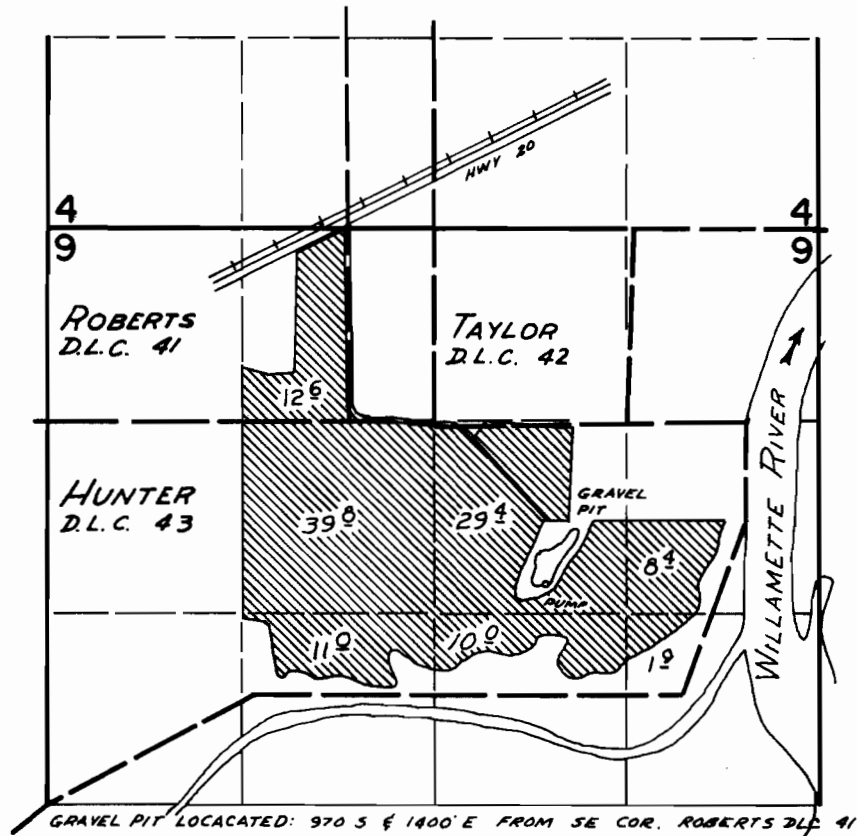

FINAL PROOF SURVEY
UNDER

Application No. G-3342 Permit No. G-3139
IN NAME OF

DON AND ADA HECTOR

Surveyed March 26, 1973, by D. NORBY