


T.11S., R.4W., W.M.

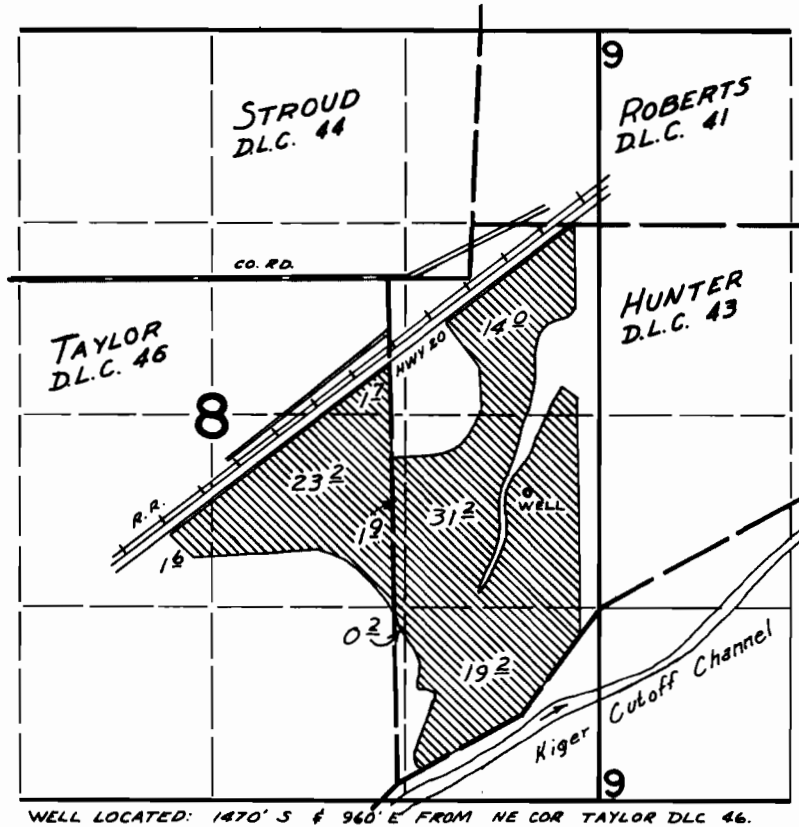

FINAL PROOF SURVEY UNDER

Application No. G-3423 Permit No. G-3209
IN NAME OF

DONALD HECTOR

Surveyed MARCH 26 1973, by D. NORBY