


T.10S., R.4W., W.M.

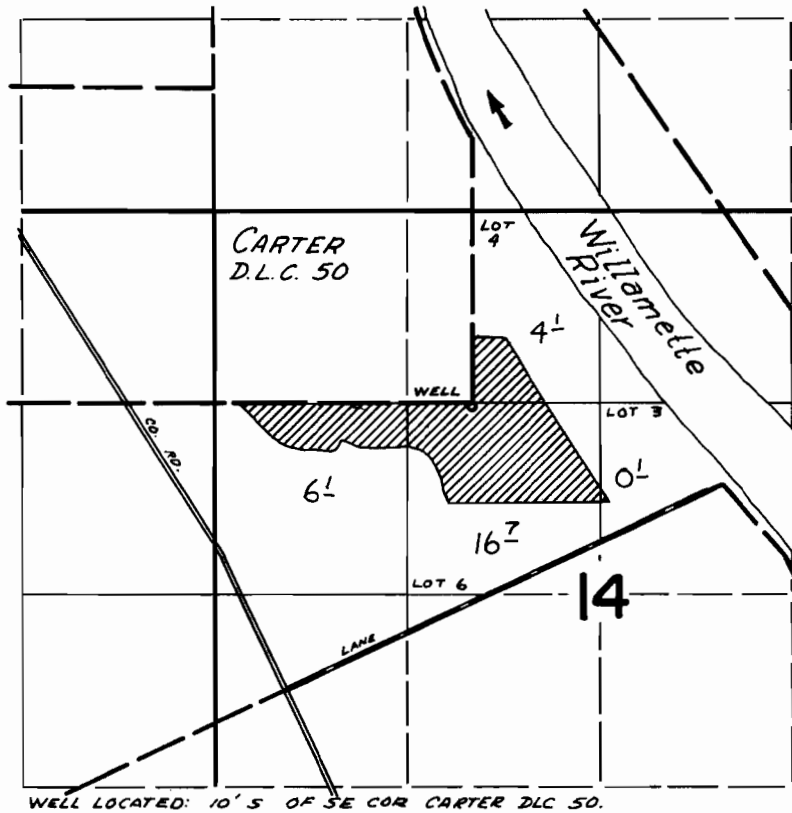

FINAL PROOF SURVEY
UNDER

Application No. G-4656 Permit No. G-4380
IN NAME OF

Dave H. Jordan

Surveyed Mar. 23 1973, by D. Norby